

CARD MUST BE TYPED

State of Kansas
NOTICE OF INTENTION TO DRILL
(see rules on reverse side)

CARD MUST BE SIGNED

Starting Date: 11 23 85
month day year

API Number 15- 153-20,642-00-00

OPERATOR: License # 5375
Name Hillenburg Oil Co.
Address 116th & S. Lynn Lane
City/State/Zip Broken Arrow, OK. 74012
Contact Person Harold Hillenburg, Jr.
Phone 1-918-455-4444

NE.. SW.. NW Sec 11. Twp 3. S, Rge 33. East
(location) West

3630 Ft North from Southeast Corner of Section
4290 Ft West from Southeast Corner of Section
(Note: Locate well on Section Plat on reverse side)

CONTRACTOR: License # 5420
Name White & Ellis Drilling, Inc.
City/State Wichita, KS: 67202

Nearest lease or unit boundary line 990 feet.
County Rawlins
Lease Name Fikan Well# 1

Domestic well within 330 feet: yes no
Municipal well within one mile: yes no

Well Drilled For: Well Class: Type Equipment:
 Oil Swd Infield Mud Rotary
 Gas Inj Pool Ext. Air Rotary
 OWWO Expl Wildcat Cable

Depth to Bottom of fresh water 150 feet
Lowest usable water formation Consolidated
Depth to Bottom of usable water 150 200 feet

Surface pipe by Alternate: 1 2
Surface pipe to be set 200 feet
Conductor pipe if any required None feet
Ground surface elevation feet MSL
This Authorization Expires 5-18-85
Approved By 11-18-85

If OWWO: old well info as follows:

Operator
Well Name
Comp Date Old Total Depth
Projected Total Depth 4400 feet
Projected Formation at TD Mississippi
Expected Producing Formations Mississippi

I certify that we will comply with K.S.A. 55-101, et seq., plus eventually plugging hole to K.C.C. specifications.

Date 11-18-85 Signature of Operator or Agent Ernest Sifford Title

White & Ellis - Sec/Treas

Form C-1 4/84

Must be filed with the K.C.C. five (5) days prior to commencing well
 This card void if drilling not started within six (6) months of date received by K.C.C.


RECEIVED
 STATE CORPORATION COMMISSION
 STATE

11-18-1985
 NOV 1 R 1985

Important procedures to follow :

A Regular Section of Land
 1 Mile = 5,280 Ft.

CONSERVATION DIVISION
 Wichita, Kansas

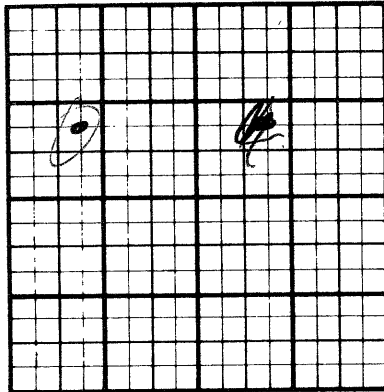

5280
 4950
 4620
 4290
 3960
 3630
 3300
 2970
 2640
 2310
 1980
 1650
 1320
 990
 660
 330

5280
 4950
 4620
 4290
 3960
 3630
 3300
 2970
 2640
 2310
 1980
 1650
 1320
 990
 660
 330

1. Notify District office before setting surface casing.
2. Set surface casing by circulating cement to the top.
3. File completion forms ACO-1 with K.C.C. within 90 days of well completion, following instructions on ACO-1, side 1, and including copies of wireline logs.
4. Notify District office 48 hours prior to old well workover or re-entry.
5. Prior to plugging, prepare a plugging plan, then obtain agreement from the appropriate district office for an approved plugging plan.
6. Submit plugging report (CP-4) to K.C.C. after plugging is completed.
7. Obtain an approved injection docket number before disposing of salt water.
8. Notify K.C.C. within 10 days when injection commences or terminates.
9. If an alternate 2 completion, cement in the production pipe from below any usable water to surface within 120 days of spud date.

State Corporation Commission of Kansas
 Conservation Division
 200 Colorado Derby Building
 Wichita, Kansas 67202
 (316) 263-3238