

RECEIVED  
STATE CORPORATION COMMISSION

STATE OF KANSAS  
KANSAS CORPORATION COMMISSION  
CONSERVATION DIVISION  
130 South Market - Room 2078  
Wichita, Kansas 67202

FORM CP-1 (3/92)

AUG - 9 1999  
08-09-99  
CONSERVATION DIVISION  
Wichita, Kansas

**WELL PLUGGING APPLICATION FORM**  
(PLEASE TYPE FORM and File ONE Copy)

API # 15-153-01001-00-01 (Identifier number of this well). This must be listed for wells drilled since 1967; if no API# was issued, indicate spud or completion date. 9/99

WELL OPERATOR Larrette Resources KCC LICENSE # 4599  
(owner/company name) (operator's)

ADDRESS 3717 Fairway Drive CITY Hays

STATE Kansas ZIP CODE 67601 CONTACT PHONE # (913) 625-2820

LEASE Beeson "OWWO" WELL# 1 SEC. 18 T. 3 R. 35W (East/West)

C - SW - SW SPOT LOCATION/QQQQ COUNTY Rawlins

660' FEET (in exact footage) FROM (S)/N (circle one) LINE OF SECTION (NOT Lease Line)

660' FEET (in exact footage) FROM E/(W) (circle one) LINE OF SECTION (NOT Lease Line)

Check One: OIL WELL  GAS WELL  D&A  SWD/ENHR WELL  DOCKET# \_\_\_\_\_

CONDUCTOR CASING SIZE \_\_\_\_\_ SET AT \_\_\_\_\_ CEMENTED WITH \_\_\_\_\_ SACKS

SURFACE CASING SIZE 8 3/4ths" SET AT 309' CEMENTED WITH \_\_\_\_\_ 150 SACKS

PRODUCTION CASING SIZE 5 1/2" SET AT 4768' cemented (1962:) 150 Sacks  
5 1/2" SET AT 1652' CEMENTED WITH (1991) 150 Sacks to surface

Production Liner 4 1/2" Set At 4207' Cemented with (1991) 275 Sacks

LIST (ALL) PERFORATIONS and BRIDGEPLUG SETS: 4382 - 4386 4 SPF

ELEVATION 3289 G.L./3293K.B.T.D. 4891' P.B.T.D. 4390' ANHYDRITE DEPTH \_\_\_\_\_ 3081'  
(G.L./K.B.) (Stone Corral Formation)

CONDITION OF WELL: GOOD  POOR  CASING LEAK  JUNK IN HOLE

PROPOSED METHOD OF PLUGGING As recommended by Field Agent.

(If additional space is needed attach separate page)

IS WELL LOG ATTACHED TO THIS APPLICATION AS REQUIRED? \_\_\_\_\_ IS ACO-1 FILED? YES

If not explain why? \_\_\_\_\_

PLUGGING OF THIS WELL WILL BE DONE IN ACCORDANCE WITH K.S.A. 55-101 et. seq. AND THE RULES AND REGULATIONS OF THE STATE CORPORATION COMMISSION.

LIST NAME OF COMPANY REPRESENTATIVE AUTHORIZED TO BE IN CHARGE OF PLUGGING OPERATIONS:

Larry Schaffer PHONE# ( ) 913-625-2820

ADDRESS 3717 Fairway Drive City/State Hays, Kansas 67601

PLUGGING CONTRACTOR Company Tools - Allied KCC LICENSE # \_\_\_\_\_  
(company name) (contractor's)

ADDRESS \_\_\_\_\_ PHONE # ( ) \_\_\_\_\_

PROPOSED DATE AND HOUR OF PLUGGING (If Known?) 10:00 Am 7/30/99


PAYMENT OF THE PLUGGING FEE (K.A.R. 82-3-118) WILL BE GUARANTEED BY OPERATOR OR AGENT

DATE: 7/29/99 AUTHORIZED OPERATOR/AGENT: [Signature]  
(signature)

BAKER SERVICE TOOLS - TALLY PAD

New Completion     Workover

Oil Company \_\_\_\_\_ Well No. 5 Field \_\_\_\_\_ Lease Baer  
Company Man \_\_\_\_\_ Date Drilled 1/78 County Ness State Kansas

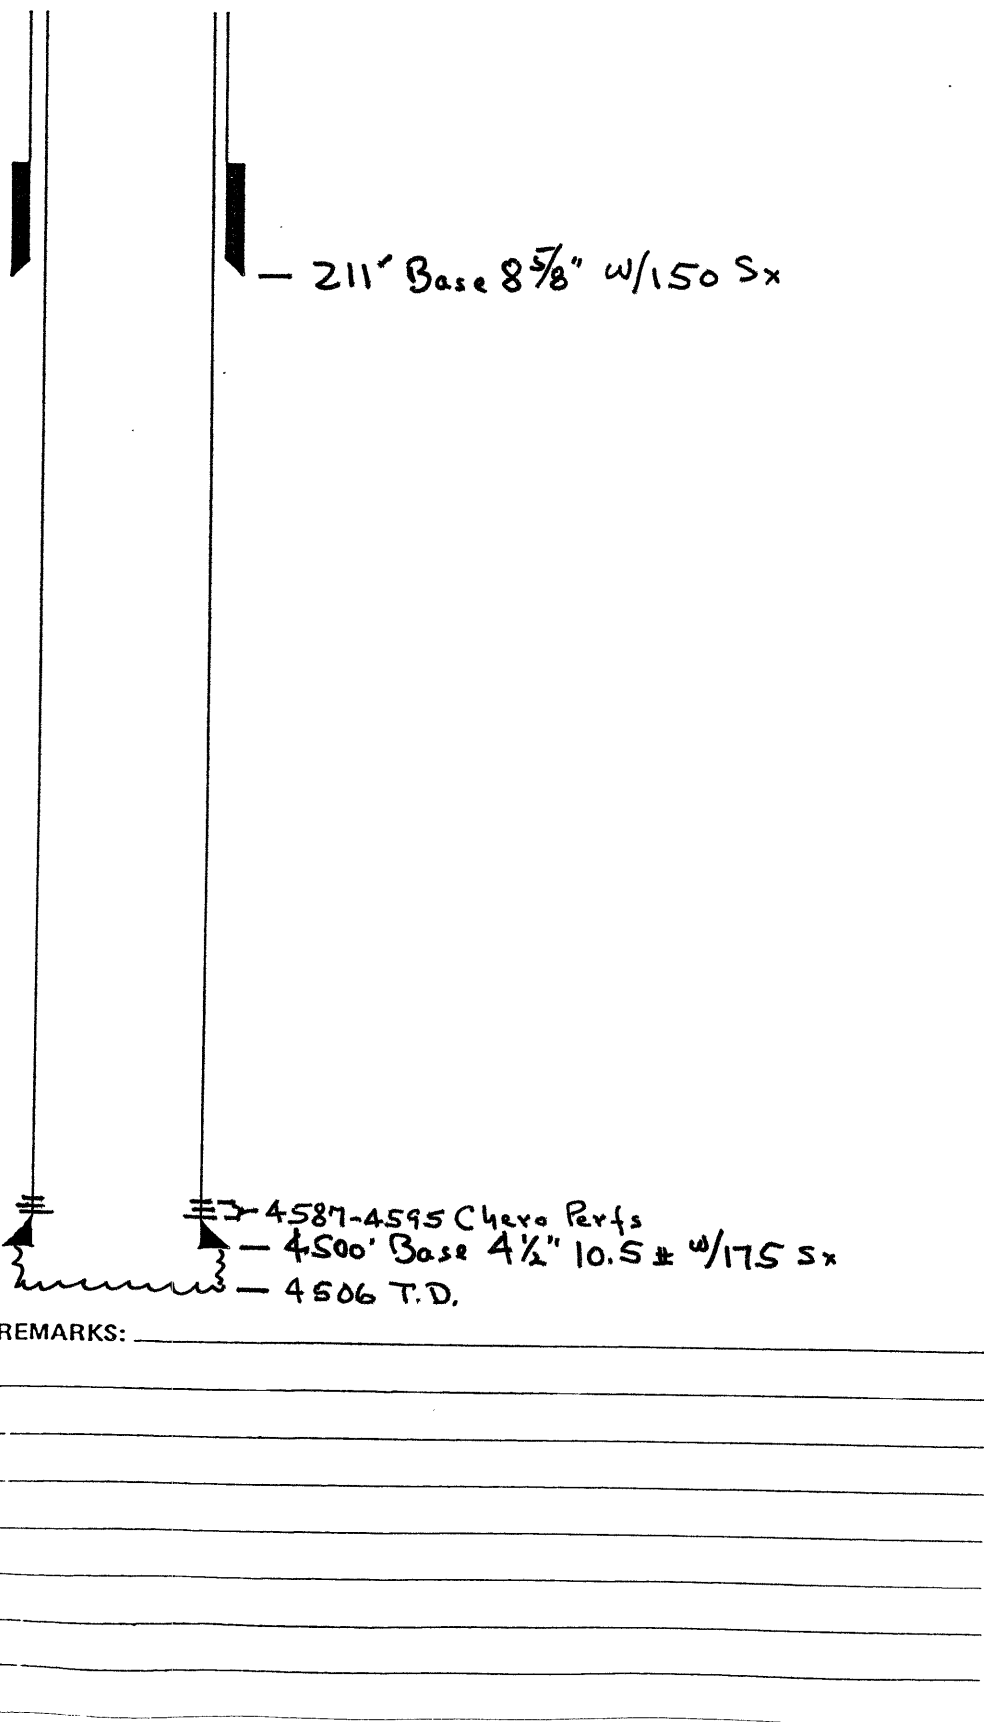

- 211' Base 8 5/8" w/150 Sx

4587-4595 Chevo Perfs  
- 4500' Base 4 1/2" 10.5 # w/175 Sx  
- 4506 T.D.

REMARKS: \_\_\_\_\_  
\_\_\_\_\_  
\_\_\_\_\_  
\_\_\_\_\_  
\_\_\_\_\_  
\_\_\_\_\_  
\_\_\_\_\_

RECEIVED  
STATE CORPORATION COMMISSION  
AUG - 9 1969  
CONSERVATION DIVISION  
Wichita, Kansas



## Kansas Corporation Commission

Bill Graves, Governor   John Wine, Chair   Cynthia L. Claus, Commissioner   Brian J. Moline, Commissioner

### NOTICE OF RECEIPT OF WELL PLUGGING APPLICATION (CP-1)

Larrette Resources  
3717 Fairway Drive  
Hays, KS 67601

August 10, 1999

BEESON OWWO #1  
API 15-153-01001-00-~~00~~01  
660 S 660 W  
C SWSW 18-3S-35W  
RAWLINS COUNTY

Dear Larry Schaffer:

This letter is to notify you that the Conservation Division is in receipt of your plugging proposal, form CP-1, for the above-captioned well.

Your CP-1 has been reviewed by the Conservation Division central office for completeness and to verify license numbers. The plugging proposal will now be forwarded to the district office listed below for review of your proposed method of plugging.

**Please contact the district office for approval of your proposed plugging method at least five (5) days before plugging the well, pursuant to K.A.R. 82-3-113 (b). If a workover pit will be used during the plugging of the well it must be permitted. A CDP-1 form must be filed and approved prior to the use of the pit.**

The Conservation Division's review of form CP-1, either in the central or district office, does not include an inquiry into well ownership or the filing operator's legal right to plug the well.

**This notice in no way constitutes authorization to plug the above-captioned well by persons not having legal rights of ownership or interest in the well. This notice is void after ninety (90) days from the above date.**

District: #4  
2301 E. 13th  
Hays, KS 67601  
(785) 625-0550

Sincerely,

A handwritten signature in cursive script, appearing to read "David P. Williams".

David P. Williams  
Production Supervisor