


15-153-19011-00-00

Give All Information Completely
Make Required Affidavit
Mail or Deliver Report to:
Conservation Division
State Corporation Commission
212 North Market, Insurance Bldg.
Wichita, Kansas

WELL PLUGGING RECORD

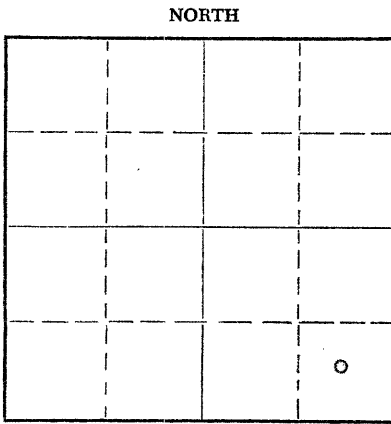

Locate well correctly on above Section Plat

Rawlins County, Sec. 13 Twp. 38 Rge. ~~26X~~ (E) 36 (W)
Location as "NE/CNW/SW" or footage from lines C SE SE
Lease Owner The Shamrock Oil and Gas Corporation
Lease Name Joe Bell Well No. 1
Office Address Box 631, Amarillo, Texas
Character of Well (completed as Oil, Gas or Dry Hole) Dry Hole
Date well completed November 10, 19 62
Application for plugging filed 12-5 19 62
Application for plugging approved 12-7 19 62
Plugging commenced 12-7 19 62
Plugging completed 12-8 19 62
Reason for abandonment of well or producing formation Dry Hole

If a producing well is abandoned, date of last production 19
Was permission obtained from the Conservation Division or its agents before plugging was commenced? Yes

Name of Conservation Agent who supervised plugging of this well Eldon Petty, P.O. Box 326, Hays, Kansas
Producing formation None Depth to top - Bottom - Total Depth of Well 4897 Feet
Show depth and thickness of all water, oil and gas formations.

OIL, GAS OR WATER RECORDS

CASING RECORD

FORMATION	CONTENT	FROM	TO	SIZE	PUT IN	PULLED OUT
				10 3/4"	320'	-0-
				7"	4760'	1,649.09'

Describe in detail the manner in which the well was plugged, indicating where the mud fluid was placed and the method or methods used in introducing it into the hole. If cement or other plugs were used, state the character of same and depth placed, from feet to feet for each plug set.

Dumped 15 sacks sand. Top of sand 4,410'. Spotted 5 sacks cement from 4,410' to 4,395'. Shot casing at 3,028' - 2,473' - and 1,980'. Casing came loose at 1,630'. Pushed wooden plug to 300'. Spotted 20 sacks cement on top of plug from 300' to 240'. Filled hole with mud to 30'. Spotted 10 sacks of cement in top of surface casing from 30' to 0'.

RECEIVED
STATE CORPORATION COMMISSION

DEC 12 1962

12-12-62

CONSERVATION DIVISION
Wichita, Kansas

(If additional description is necessary, use BACK of this sheet)
Name of Plugging Contractor Forbes Casing Pullers, Inc.
Address Box 221, Great Bend, Kansas.

STATE OF Texas, COUNTY OF Potter, ss.
T. S. Clopton (employee of owner) or (owner or operator) of the above-described well, being first duly sworn on oath, says: That I have knowledge of the facts, statements, and matters herein contained and the log of the above-described well as filed and that the same are true and correct. So help me God.

(Signature) T. S. Clopton

Box 631, Amarillo, Texas
(Address)

SUBSCRIBED AND SWORN TO before me this 10th day of December, 19 62

Pauline Powell
Notary Public
Potter County, Texas

My commission expires 6-1-63

15-153-19011-00-00

JOE BELL NO. 1
Sec. 13, Twp. 3S, Rge 36W
Rawlins County, Kansas

0'	340'	Sand & shale
340'	2,395'	Shale
2,395'	2,610'	Shale & shells
2,610'	2,720'	Shale, pyrite, & gyp
2,720'	2,950'	Shale and gyp
2,950'	3,097'	Shale
3,097'	3,141'	Anhydrite
3,141'	3,180'	Shale
3,180'	3,350'	Shale & shells
3,350'	4,220'	Shale & lime
4,220'	4,375'	Lime
4,375'	4,435'	Lime & shale
4,435'	4,475'	Lime
4,475'	4,550'	Lime & shale
4,550'	4,630'	Lime
4,630'	4,670'	Lime & shale
4,670'	4,686'	Lime
4,686'	4,785'	Lime & shale
4,785'	4,810'	Lime & sand
4,810'	4,851'	Lime & chert
4,851'	4,897'	Lime & shale

Flight/Union Skin

RECEIVED
STATE CORPORATION COMMISSION

DEC 7 1962

12-7-62

CONSERVATION DIVISION
Wichita, Kansas

J. S. Clopton