

15-153-20387-00-00


SE SW

STATE OF KANSAS
STATE CORPORATION COMMISSION

WELL PLUGGING RECORD

Give All Information Completely
Make Required Affidavit
Mail or Deliver Report to
Conservation Division
State Corporation Comm.
245 North Water
Wichita, KS 67202

Rawlins County. Sec. 21 Twp. 3 S Rge. 36 W E/W
Location as "NE/CNW $\frac{1}{4}$ SW $\frac{1}{4}$ " or footage from lines
660' from Se line + 660' from East line
Lease Owner Clark-Cahoj Ltd
Lease Name H. Cahoj No 1 Well No. 1
Office Address Box 13, McDonald, Mo. 67745
Character of Well (Completed as Oil, Gas or Dry Hole) dry

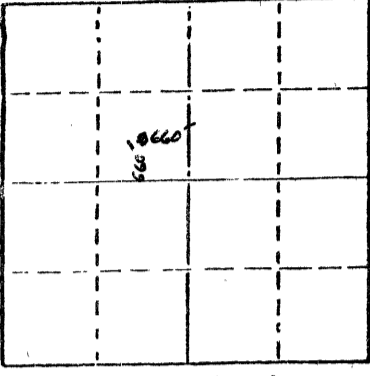

Locate well correctly on above
Section Plot

Date Well completed _____ 19____
Application for plugging filed 8/7 by phone 1980
Application for plugging approved 8/7 by phone 1980
Plugging commenced 8/7 1980
Plugging completed 8/8/80 1980
Reason for abandonment of well or producing formation
no pressure
If a producing well is abandoned, date of last production _____ 19____

Was permission obtained from the Conservation Division or its agents before plugging was commenced? yes

Name of Conservation Agent who supervised plugging of this well Frank Bradford - by phone
Producing formation Ks. city Depth to top 4250 Bottom 4272 Total Depth of Well 4550
Show depth and thickness of all water, oil and gas formations.

OIL, GAS OR WATER RECORDS

CASING RECORD

FORMATION	CONTENT	FROM	TO	SIZE	PUT IN	PULLED OUT

Describe in detail the manner in which the well was plugged, indicating where the mud fluid was placed and the method or methods used in introducing it into the hold. If cement or other plugs were used, state the character of same and depth placed, from _____ feet to _____ feet for each plug set. six sacks cement at 4050 ft
Halliburton set plug at 325 ft, ran 25 sacks of cement. Ran 2nd plug at 40 ft, ran 15 sacks of cement to top.

RECEIVED
STATE CORPORATION COMMISSION

AUG 27 1980

CONSERVATION DIVISION
Wichita, Kansas

F-27-80

(If additional description is necessary, use BACK of this sheet)

Name of Plugging Contractor Halliburton

STATE OF Kansas COUNTY OF Rawlins, ss.
Edward J. Cahoj (employee of owner) or (owner or operator)

of the above-described well, being first duly sworn on oath, says: That I have knowledge of the facts, statements, and matters herein contained and the log of the above-described well as filed and that the same are true and correct. So help me God.

(Signature) Edward J. Cahoj
Clark-Cahoj Ltd.
Box 13, McDonald, Mo. 67745
(Address)

SUBSCRIBED AND SWORN TO before me this 26th day of August, 19 80

Hazel M. Richards
Notary Public.

My commission expires May 5, 1983

