

15-153-20284-00-00


STATE OF KANSAS
STATE CORPORATION COMMISSION

WELL PLUGGING RECORD

Give All Information Completely
Make Required Affidavit
Mail or Deliver Report to
Conservation Division
State Corporation Comm.
245 North Water
Wichita, KS 67202

Rawlins County, Sec. 2 Twp. 3S Rge. 33 E/W
Location as "NE/CNW $\frac{1}{4}$ SW $\frac{1}{4}$ " or footage from lines
C NW SE

Lease Owner Bass Enterprises Production Co.
Lease Name Hennenberger Well No. #1
Office Address 2760 - Vaughn Bldg., Midland, Texas 79701
Character of Well (Completed as Oil, Gas or Dry Hole)
Dry Hole

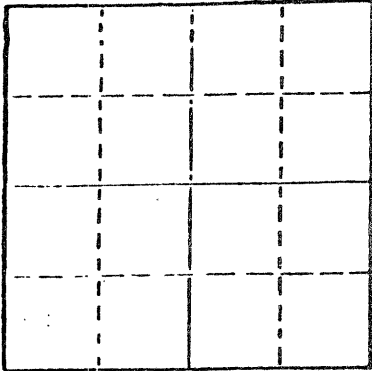

Locate well correctly on above
Section Plat

Date Well completed 5-24-77 19
Application for plugging filed 5-24-77 19
Application for plugging approved 5-24-77 19
Plugging commenced 5-24-77 19
Plugging completed 5-24-77 19
Reason for abandonment of well or producing formation
Commercial quantities of oil not found
If a producing well is abandoned, date of last production 19

Was permission obtained from the Conservation Division or
its agents before plugging was commenced? Yes

Name of Conservation Agent who supervised plugging of this well Gilbert Balthazor, Palco, Ks.
Producing formation Depth to top Bottom Total Depth of Well 4062'
Show depth and thickness of all water, oil and gas formations.

OIL, GAS OR WATER RECORDS

CASING RECORD

FORMATION	CONTENT	FROM	TO	SIZE	PUT IN	PULLED OUT
				8 5/8"	249'	None

Describe in detail the manner in which the well was plugged, indicating where the mud fluid
was placed and the method or methods used in introducing it into the hold. If cement or other
plugs were used, state the character of same and depth placed, from _____ feet to
_____ feet for each plug set.

Plug @ 1750' w/70 sx.
Plug @ 240' w/20 sx.
Plug @ 40' w/10 sx.

RECEIVED
STATE CORPORATION COMMISSION
JUN 03 1977
06-03-1977
CONSERVATION DIVISION
Wichita, Kansas

(If additional description is necessary, use BACK of this sheet)

Name of Plugging Contractor Rains & Williamson Oil Co., Inc.

STATE OF Kansas COUNTY OF Sedgwick, ss.

Wilson Rains, President of Rains & Williamson Oil Co., Inc. (employee of owner) or (owner or operator)
of the above-described well, being first duly sworn on oath, says: That I have knowledge of
the facts, statements, and matters herein contained and the log of the above-described well
as filed and that the same are true and correct. So help me God.

(Signature) Wilson Rains
435 Page Court, 220 W. Douglas, Wichita, Ks. 67202
(Address)

SUBSCRIBED AND SWORN TO before me this 25 day of May, 19 77

My commission expires 10-4-79

Juanita M. Green
Juanita M. Green Notary Public.



DRILLER'S LOG

15-153-20284-00-00

COMPANY: Bass Enterprises Production Co.

SEC. 2 T. 3S R. 33W

LOC. C NW SE

WELL NAME: Hennenberger #1

COUNTY: Rawlins

RIG NO. #1

TOTAL DEPTH 4062'

ELEVATION

COMMENCED: 5-14-77

COMPLETED: 5-24-77

CONTRACTOR: Rains & Williamson Oil Co., Inc.

CASING RECORD:

SURFACE: 8 5/8" @ 249' w/200 sx. 50/50 poz., 3% cc., 2% gel.

PRODUCTION: D&A

LOG

(Figures Indicate Bottom of Formations)

Sand, Clay & Shale	200
Shale	250
Shale & Sand	1935
Shale, Lime & Sand	2440
Shale & Sand	3012
Lime	3154
Shale, Sand & Lime	3445
Lime	3586
Shale & Lime	3850
Lime	4062
<u>ROTARY TOTAL DEPTH</u>	<u>4062</u>

RECEIVED
STATE CORPORATION COMMISSION

JUN 03 1977
06-03-1977
CONSERVATION DIVISION
Wichita, Kansas

STATE OF Kansas)

COUNTY OF Sedgwick)

SS:

I, Wilson Rains, President of Rains & Williamson Oil Co., Inc.

upon oath state that the above and foregoing is a true and correct copy of the log of the

Hennenberger #1 well.

Wilson Rains
Wilson Rains

Subscribed and sworn to before me this 25 day of May, 1977.

My Appointment Expires:

10-4-79

Juanita M. Green
Juanita M. Green

