


STATE OF KANSAS
STATE CORPORATION COMMISSION

15-153-00003-00-00

Give All Information Completely
Make Required Affidavit
Mail or Deliver Report to:
Conservation Division
State Corporation Commission
211 No. Broadway
Wichita, Kansas

WELL PLUGGING RECORD

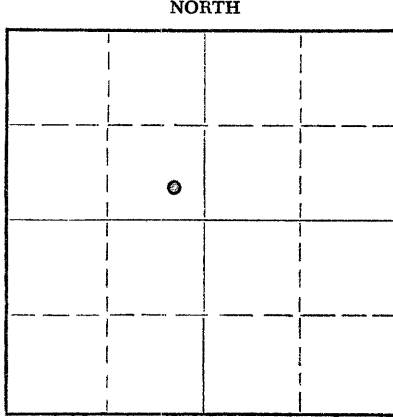

Locate well correctly on above Section Plat

Rawlins County. Sec. 1 Twp. 3S Rge. 36 (X) (W)
Location as "NE/CNW/SW" or footage from lines 2310' from North and West
Lease Owner The Shamrock Oil and Gas Corporation
Lease Name Edith B. Gaines et al "B" Well No. 1
Office Address Box 631, Amarillo, Texas
Character of Well (completed as Oil, Gas or Dry Hole) Dry Hole
Date well completed 9-23 1958
Application for plugging filed 9-23 1958
Application for plugging approved 9-23- 1958
Plugging commenced 9-23- 1958
Plugging completed 9-23 1958
Reason for abandonment of well or producing formation Dry

If a producing well is abandoned, date of last production _____ 19____
Was permission obtained from the Conservation Division or its agents before plugging was commenced? Yes

Name of Conservation Agent who supervised plugging of this well Merle Rives
Producing formation _____ Depth to top _____ Bottom _____ Total Depth of Well 4901 Feet
Show depth and thickness of all water, oil and gas formations.

OIL, GAS OR WATER RECORDS

CASING RECORD

FORMATION	CONTENT	FRDM	TD	SIZE	PUT IN	PULLED OUT
Sand	Pos. water	110	250	8 5/8"	300	0

Describe in detail the manner in which the well was plugged, indicating where the mud fluid was placed and the method or methods used in introducing it into the hole. If cement or other plugs were used, state the character of same and depth placed, from _____ feet to _____ feet for each plug set.

Spotted 20 sacks cement at 600' and 20 sacks at 295'. Pushed 8 5/8" OD Halliburton plug to 40'. Filled casing with 10 sacks cement from 40' to base of cellar.

(If additional description is necessary, use BACK of this sheet)

Name of Plugging Contractor Halliburton Oil Well Cementing Company
Address Great Bend, Kansas

STATE OF TEXAS, COUNTY OF POTTER, ss.
T. S. Clopton (employee of owner) or (~~SWAMP OPERATOR~~) of the above-described

well, being first duly sworn on oath, says: That I have knowledge of the facts, statements, and matters herein contained and the log of the above-described well as filed and that the same are true and correct. So help me God.

(Signature) T. S. Clopton

Box 631, Amarillo, Texas
(Address)

SUBSCRIBED AND SWORN TO before me this 25th day of September, 19 58

Pauline Powell
Notary Public
Potter County, Texas

My commission expires _____

RECEIVED
STATE CORPORATION COMMISSION
9-26-58

SEP 26 1958

CONSERVATION DIVISION
Wichita, Kansas

9-26-58

PLUGGING
FILE SEC 1 T 3 R 36W
BOOK PAGE 132 LINE 36

15-193-00003-00-00

EDITH B. GAINES ET AL "B" NO. 1
Section 1, Township 3 South, Range 36 West
Rawlins County, Kansas

45' - 110'	Clay with sand streaks
110' - 250'	Sand
250' - 580'	Shale
580' - 1,725'	Shale & sand
1,725' - 1,800'	Shells & shale
1,800' - 1,895'	Shale
1,895' - 2,180'	Shale & sand
2,180' - 2,405'	Shale
2,405' - 2,500'	Shale & shells
2,500' - 2,525'	Sand
2,525' - 2,608'	Shale, lime & sand
2,608' - 2,630'	Sand
2,630' - 2,680'	Sand & shale
2,680' - 2,905'	Lime & shale
2,905' - 3,075'	Lime, shale, & red beds
3,075' - 3,115'	Anhydrite
3,115' - 3,145'	Shale
3,145' - 3,460'	Shale & lime
3,460' - 3,550'	Sand, shale, & lime
3,550' - 3,865'	Lime & shale
3,865' - 4,107'	Lime
4,107' - 4,180'	Lime & shale
4,180' - 4,337'	Lime
4,337' - 4,407'	Lime & shale
4,407' - 4,692'	Lime
4,692' - 4,722'	Shale & sand
4,722' - 4,835'	Lime and shale
4,835' - 4,901'	Lime

RECEIVED
STATE CORPORATION COMMISSION

SEP 26 1958 9-26-58

CONSERVATION DIVISION
Wichita, Kansas

PLUGGING			
FILE	SEC	1 T. 3	R 36W
BOOK	PAGE	132	LINE 36