

CARD MUST BE TYPED

State of Kansas  
**NOTICE OF INTENTION TO DRILL**  
(see rules on reverse side)

CARD MUST BE SIGNED

Starting Date: September 22, 1984  
month day year

API Number 15- 153-20,575-00-00

OPERATOR: License # 5447  
Name Cities Service Oil & Gas Corp.  
Address 800 Sutton Place Bldg., 209E. William  
City/State/Zip Wichita, Kansas 67202  
Contact Person Gary A. Johnson  
Phone 316 265-5624

APC NW NE (location) Sec 29 Twp 3 S, Rge 36  East  West

CONTRACTOR: License # 5146  
Name Rains & Williamson  
City/State Wichita, Kansas 67202

4620 Ft North from Southeast Corner of Section  
1830 Ft West from Southeast Corner of Section  
(Note: Locate well on Section Plat on reverse side)

Nearest lease or unit boundary line 660 feet.  
County Rawlins  
Lease Name Hubbard "C" Well# 1

Domestic well within 330 feet:  yes  no  
Municipal well within one mile:  yes  no

Well Drilled For: Well Class: Type Equipment:  
 Oil  Swd  Infield  Mud Rotary  
 Gas  Inj  Pool Ext.  Air Rotary  
 OWWO  Expl  Wildcat  Cable

Depth to Bottom of fresh water 300 feet  
Lowest usable water formation 350 4' in concrete  
Depth to Bottom of usable water 350 290 feet  
Surface pipe by Alternate: 1  2   
Surface pipe to be set 350 feet  
Conductor pipe if any required None feet  
Ground surface elevation 3262 feet MSL  
This Authorization Expires 3-14-85  
Approved By 9-14-84 RC

If OWWO: old well info as follows:

Operator .....,  
Well Name .....,  
Comp Date ....., Old Total Depth .....,  
Projected Total Depth 4700 feet  
Projected Formation at TD Cherokee  
Expected Producing Formations Lansing, Cherokee

I certify that we will comply with K.S.A. 55-101, et seq., plus eventually plugging hole to K.C.C. specifications.

Date 9-14-84 Signature of Operator or Agent

Gary A. Johnson

Title Petroleum Engineer

Form C-1 4/84


W. H. K. ONE 9/14/84

Must be filed with the K.C.C. five (5) days prior to commencing well  
This card void if drilling not started within six (6) months of date received by K.C.C.

RECEIVED  
WICHITA, KANSAS

9-14-84  
SEP 14 1984

A Regular Section of Land  
1 Mile 5,280 Ft.  
RECEIVED  
STATE CORPORATION COMMISSION

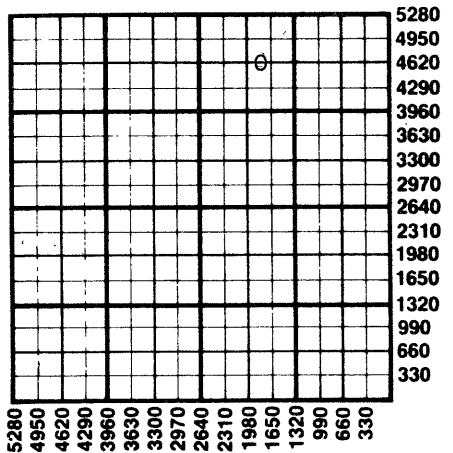

**Important procedures to follow:**

1. Notify District office before setting surface casing.
2. Set surface casing by circulating cement to the top.
3. File completion forms ACO-1 with K.C.C. within 90 days of well completion, following instructions on ACO-1, side 1, and including copies of wireline logs.
4. Notify District office 48 hours prior to old well workover or re-entry.
5. Prior to plugging, prepare a plugging plan, then obtain agreement from the appropriate district office for an approved plugging plan.
6. Submit plugging report (CP-4) to K.C.C. after plugging is completed.
7. Obtain an approved injection docket number before disposing of salt water.
8. Notify K.C.C. within 10 days when injection commences or terminates.
9. If an alternate 2 completion, cement in the production pipe from below any usable water to surface within 120 days of spud date.

State Corporation Commission of Kansas  
Conservation Division  
200 Colorado Derby Building  
Wichita, Kansas 67202  
(316) 263-3238