


15-023-0002600-00

STATE OF KANSAS  
STATE CORPORATION COMMISSION

Give All Information Completely  
Make Required Affidavit  
Mail or Deliver Report to:  
Conservation Division  
State Corporation Commission  
211 No. Broadway  
Wichita, Kansas

WELL PLUGGING RECORD

NORTH

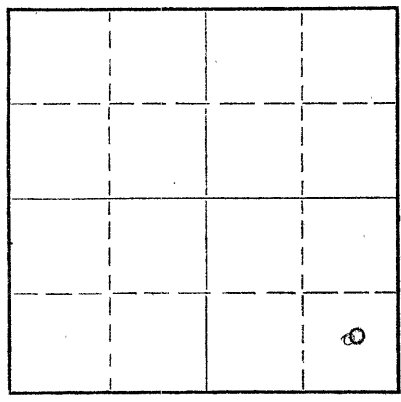

Locate well correctly on above  
Section Plat

Cheyenne County. Sec. 18 Twp. 3S Rge. 39 (E) W (W)  
Location as "NE/CNW4SW4" or footage from lines C SE SE  
Lease Owner Curt Brown Drilling Company  
Lease Name Fancannon Well No. 1  
Office Address 516 Mayo Building, Tulsa 3, Oklahoma  
Character of Well (completed as Oil, Gas or Dry Hole) Dry hole  
Date well completed November 20 19 59  
Application for plugging filed November 20 19 59  
Application for plugging approved November 20 19 59  
Plugging commenced November 20 19 59  
Plugging completed November 20 19 59  
Reason for abandonment of well or producing formation dry hole

If a producing well is abandoned, date of last production \_\_\_\_\_ 19\_\_\_\_  
Was permission obtained from the Conservation Division or its agents before plugging was commenced? yes

Name of Conservation Agent who supervised plugging of this well Mr. Fabricus  
Producing formation \_\_\_\_\_ Depth to top \_\_\_\_\_ Bottom \_\_\_\_\_ Total Depth of Well 5250 Feet  
Show depth and thickness of all water, oil and gas formations.

OIL, GAS OR WATER RECORDS

CASING RECORD

FORMATION	CONTENT	FROM	TO	SIZE	PUT IN	BOILED OUT

RECEIVED  
STATE CORPORATION COMMISSION  
DEC 2 1959  
CONSERVATION DIVISION  
12-2-59

Describe in detail the manner in which the well was plugged, indicating where the mud fluid was placed and the method or methods used in introducing it into the hole. If cement or other plugs were used, state the character of same and depth placed, from \_\_\_\_\_ feet to \_\_\_\_\_ feet for each plug set.

Pumped ~~the~~ hole full to top with heavy rotary mud and spotted  
20 sacks cement at the 550 feet level  
20 " " at the 250 feet level  
10 " " at the 40 feet level to top of surface  
pipe which is two feet below ground level.

(If additional description is necessary, use BACK of this sheet)

Name of Plugging Contractor Curt Brown Drilling Company  
Address 516 Mayo Building, Tulsa 3, Oklahoma

STATE OF Oklahoma, COUNTY OF Tulsa, ss.  
owner (employee of owner) or (owner or operator) of the above-described well, being first duly sworn on oath, says: That I have knowledge of the facts, statements, and matters herein contained and the log of the above-described well as filed and that the same are true and correct. So help me God.

(Signature) Curt Brown  
516 Mayo Bldg., Tulsa 3, Oklahoma  
(Address)

SUBSCRIBED AND SWORN TO before me this 24th day of November, 19 59

Lloyd S. Miller  
Notary Public.

My commission expires 8/12/62



15-023-00026-00-00

RECEIVED  
STATE CORPORATION COMMISSION

FORMATION RECORD for the Fancannon well #1  
Cheyenne County, Kansas - Section 18-3S-39W

DEC 2 1959

CONSERVATION DIVISION  
Wichita, Kansas

Curt Brown Drilling Company - Contractor  
516 Mayo Building  
Tulsa 3, Oklahoma

Drilling Started - October 29, 1959  
Drilling Finished - November 20, 1959

Ran 244.39' of 8-5/8" Surface Casing  
cemented with 300 sacks cement.

Formation Record:

<u>Top</u>	<u>Bottom</u>	<u>Formation</u>
0	265	Sand & shale
265	1350	Shale
1350	1516	Sand & shale
1516	1626	Shale
1626	1951	Shale & sand
1951	2060	Shale
2060	2484	Lime & shale
2484	2801	Shale & lime
2801	2921	Lime & shale & sand
2921	2942	Sand & lime
2942	3027	Sand & shale
3027	3132	Lime & shale
3132	3255	Lime & sand & shale
3255	3306	Shale & lime
3306	3409	Lime & shale
3409	3474	Shale
3474	3489	Lime & Sand
3489	3513	Shale & sand
3513	3542	Shale & lime
3542	3608	Lime & shale
3608	3692	Lime & shale & sand
3692	3901	Shale & lime
3901	4003	Lime & shale
4003	4075	Shale & lime
4075	4147	Lime (Gyp) & Shale
4147	4244	Lime
4244	4402	Lime & shale
4402	4427	Lime
4427	4469	Lime & shale
4469	4556	Lime
4556	4627	Lime & shale
4627	4658	Lime
4658	4690	Lime & shale
4690	4717	Shale & lime streaks
4717	4858	Lime
4858	4881	Lime & shale
4881	4932	Lime
4932	4975	Lime & shale
4975	4989	Lime
4989	5026	Sand & shale
5026	5070	Shale & lime
5070	5085	Lime
5085	5125	Shale & sandy lime
5125	5160	Lime & chert
5160	5211	Cherty lime & shale
5211	5229	Lime & shale
5229	5250	Shale

T. D.