

STATE CORPORATION COMMISSION OF KANSAS  
OIL & GAS CONSERVATION DIVISION

WELL COMPLETION OR RECOMPLETION FORM  
ACO-1 WELL HISTORY

DESCRIPTION OF WELL AND LEASE

Operator: License # 4528  
Name Paul Priatel  
Address 201 W. 8th St., Suite 450  
City/State/Zip Pueblo, Colorado 81003

Purchaser NA

Operator Contact Person Paul Priatel  
Phone (303) 544-2111

Contractor: License # 8682  
Name Golden Eagle Drilling, Inc.

Wellsite Geologist Paul Priatel  
Phone (303) 544-2111

Designate Type of Completion

New Well  Re-Entry  Workover

Oil  SWD  Temp Abd  
 Gas  Inj  Delayed Comp.  
 Dry  Other (Core, Water Supply etc.)

If OMO: old well info as follows:

Operator  
Well Name  
Comp. Date Old Total Depth

WELL HISTORY

Drilling Method:

Mud Rotary  Air Rotary  Cable

Spud Date 4/5/86 Date Reached TD 4/12/86 Completion Date 4/12/86

Total Depth 4870 PBTD

Amount of Surface Pipe Set and Cemented at 410 feet  
Multiple Stage Cementing Collar Used?  Yes  No  
If yes, show depth set... feet  
If alternate 2 completion, cement circulated from... feet depth to... W/... SX cmt

API NO. 15-023-20245-00-00  
County Cheyenne  
NW SW NW Sec 12 Twp 3S Rge 37  East  West

3630 Ft North from Southeast Corner of Section  
4950 Ft West from Southeast Corner of Section  
(Note: Locate well in section plat below)


Lease Name Briney Well # 12-24

Field Name NA

Producing Formation NA

Elevation: Ground 3399 KB 3404

Section Plat

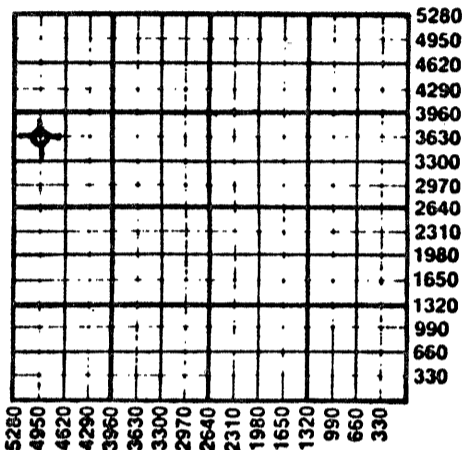

WATER SUPPLY INFORMATION

Disposition of Produced Water:  Disposal  Repressuring  
Docket #

Questions on this portion of the ACO-1 call:

Water Resources Board (913) 296-3717

Source of Water:

Division of Water Resources Permit #

Groundwater 2970 Ft North from Southeast Corner (Well) 429 Ft West from Southeast Corner of Sec 12 Twp 3S Rge 37  East  West

Surface Water... Ft North from Southeast Corner (Stream, pond etc)... Ft West from Southeast Corner Sec Twp Rge  East  West

Other (explain) (purchased from city, R.W.D. #)

INSTRUCTIONS: This form shall be completed in duplicate and filed with the Kansas Corporation Commission, 200 Colorado Derby Building, Wichita, Kansas 67202, within 90 days after completion or recompletion of any well. Rule 82-3-130 and 82-3-107 apply. Information on side two of this form will be held confidential for a period of 12 months if requested in writing and submitted with the form. See rule 82-3-107 for confidentiality in excess of 12 months. One copy of all wireline logs and drillers time log shall be attached with this form. Submit CP-4 form with all plugged wells. Submit CP-111 form with all temporarily abandoned wells.

All requirements of the statutes, rules and regulations promulgated to regulate the oil and gas industry have been fully complied with and the statements herein are complete and correct to the best of my knowledge.

Signature Paul Priatel

Title Geologist/Operator Date 5/27/86

Subscribed and sworn to before me this 27th day of May 1986

Notary Public

Date Commission Expires 5/31/98

BUSINESS ADDRESS:  
201 W. 8TH STREET  
WICHITA, KANSAS 67202

11/10/85  
10-2-86  
CONSERVATION DIVISION  
Wichita, Kansas

K.C.C. OFFICE USE ONLY  
 Letter of Confidentiality Attached  
 Wireline Log Received  
 Drillers Timelog Received  
Distribution  
 KCC  SWD/Rep  NGPA  
 KGS  Plug  Other (Specify)

Sec 12, Twp 3, Rge 37