


STATE OF KANSAS  
STATE CORPORATION COMMISSION

15-23-00025-00-00

WELL PLUGGING RECORD

Give All Information Completely  
Make Required Affidavit  
Mail or Deliver Report to:  
Conservation Division  
State Corporation Commission  
211 No. Broadway  
Wichita, Kansas

NORTH

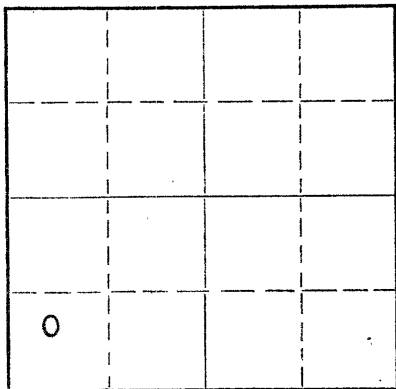

Locate well correctly on above  
Section Plat

Cheyenne County. Sec. 15 Twp. 3S Rge. 4E (E) W (W)  
Location as "NE/CNW/SW" or footage from lines C- SW SW Sec. 15-3S-4E  
Lease Owner Curt Brown Drilling Company / Norbla Oil Co.  
Lease Name Knorr Well No. 1  
Office Address 516 Mayo Building, Tulsa 3, Oklahoma  
Character of Well (completed as Oil, Gas or Dry Hole) dry hole  
Date well completed 12/11/59 19  
Application for plugging filed 12/11/59 19  
Application for plugging approved 12/11/59 19  
Plugging commenced 12/11/59 19  
Plugging completed 12/11/59 19  
Reason for abandonment of well or producing formation dry hole

If a producing well is abandoned, date of last production 19

Was permission obtained from the Conservation Division or its agents before plugging was commenced? yes

Name of Conservation Agent who supervised plugging of this well Mr. Fabricus

Producing formation \_\_\_\_\_ Depth to top \_\_\_\_\_ Bottom \_\_\_\_\_ Total Depth of Well 5313 Feet

Show depth and thickness of all water, oil and gas formations.

OIL, GAS OR WATER RECORDS

CASING RECORD

FORMATION	CONTENT	FROM	TO	SIZE	PUT IN	PULLED OUT

Describe in detail the manner in which the well was plugged, indicating where the mud fluid was placed and the method or methods used in introducing it into the hole. If cement or other plugs were used, state the character of same and depth placed, from \_\_\_\_\_ feet to \_\_\_\_\_ feet for each plug set.

Pumped hole full to top with heavy rotary mud, spotted  
20 saks cement at the 500 feet level  
20 saks cement at the 250 feet level  
10 saks cement at the 40 feet level to top of surface  
pipe two feet below ground level

RECEIVED  
STATE CORPORATION COMMISSION  
DEC 24 1959  
CONSERVATION DIVISION  
Wichita, Kansas

12-24-59

(If additional description is necessary, use BACK of this sheet)

Name of Plugging Contractor Curt Brown Drilling Company  
Address 516 Mayo Building, Tulsa 3, Oklahoma

STATE OF Oklahoma, COUNTY OF Tulsa, ss. owner (employee of owner) or (owner or operator) of the above-described well, being first duly sworn on oath, says: That I have knowledge of the facts, statements, and matters herein contained and the log of the above-described well as filed and that the same are true and correct. So help me God.

(Signature) Curt Brown  
516 May Bldg, Tulsa 3, Oklahoma  
(Address)

SUBSCRIBED AND SWORN TO before me this 14 day of December, 1959

Leopold Miller

My commission expires 8/12/62

Notary Public.

