

CARD MUST BE TYPED

State of Kansas
NOTICE OF INTENTION TO DRILL
(see rules on reverse side)

CARD MUST BE SIGNED

Starting Date: April 25, 1985
month day year

API Number 15- 153-20,605-00-00

OPERATOR: License # 9095
Name Grynberg Petroleum Company
Address 5000 S. Quebec, Suite 500
City/State/Zip Denver, Colorado 80237
Contact Person Fred Davis
Phone (O) 303-850-7490 (H) 303-722-3562

East
.NW-NE-SW ... Sec .32. Twp ..3. S, Rge 36.. West
(location)

~~300~~ 230 Ft North from Southeast Corner of Section
~~300~~ 230 Ft West from Southeast Corner of Section
(Note: Locate well on Section Plat on reverse side) ✓

CONTRACTOR: License # 8682
Name Golden Eagle Drilling, Inc.
City/State McCook, Nebraska 69001

Nearest lease or unit boundary line 330 feet.
County Rawlins
Lease Name Officer Well# 1

Domestic well within 330 feet : yes no
Municipal well within one mile : yes no

Well Drilled For: **Well Class:** **Type Equipment:**
 Oil Swd Infield Mud Rotary
 Gas Inj Pool Ext. Air Rotary
 OWWO Expl Wildcat Cable

Depth to Bottom of fresh water 300 feet
Lowest usable water formation Ogallala
Depth to Bottom of usable water 300 350 ^{min} feet

If OWWO: old well info as follows:
Operator
Well Name
Comp Date Old Total Depth
Projected Total Depth 4750 feet
Projected Formation at TD Lower Cherokee
Expected Producing Formations Lansing-Kansas City, Cherokee Marmat

Surface pipe by Alternate : 1 2
Surface pipe to be set 400 feet
Conductor pipe if any required 77 feet
Ground surface elevation 3340 feet MSL
This Authorization Expires 10-29-85
Approved By 4-29-85 PC

I certify that we will comply with K.S.A. 55-101, et seq., plus eventually plugging hole to K.C.C. specifications.

Date 4-24-1985 Signature of Operator or Agent

M. [Signature] Title Exp. Mgr.
Form C-1 4/84
W.H.C. / M.D.H.E. 4-29-85


RECEIVED
STATE CORPORATION COMMISSION

Must be filed with the K.C.C. five (5) days prior to commencing well
This card void if drilling not started within six (6) months of date received by K.C.C.

APR 20

4-29-85

CONSERVATION DIVISION
Wichita, Kansas
A Regular Section of Land
1 Mile = 5,280 Ft.

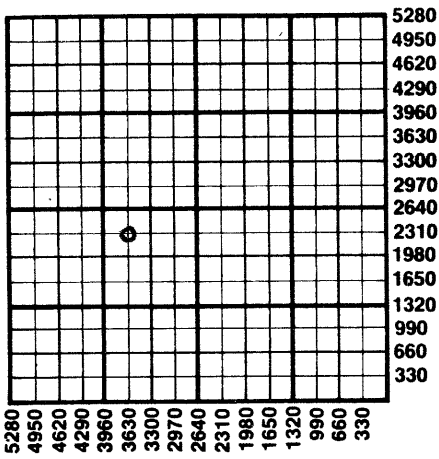

Important procedures to follow :

1. Notify District office before setting surface casing.
2. Set surface casing by circulating cement to the top.
3. File completion forms ACO-1 with K.C.C. within 90 days of well completion, following instructions on ACO-1, side 1, and including copies of wireline logs.
4. Notify District office 48 hours prior to old well workover or re-entry.
5. Prior to plugging, prepare a plugging plan, then obtain agreement from the appropriate district office for an approved plugging plan.
6. Submit plugging report (CP-4) to K.C.C. after plugging is completed.
7. Obtain an approved injection docket number before disposing of salt water.
8. Notify K.C.C. within 10 days when injection commences or terminates.
9. If an alternate 2 completion, cement in the production pipe from below any usable water to surface within 120 days of spud date.

State Corporation Commission of Kansas
Conservation Division
200 Colorado Derby Building
Wichita, Kansas 67202
(316) 263-3238