

CARD MUST BE TYPED

State of Kansas
NOTICE OF INTENTION TO DRILL

CARD MUST BE SIGNED

(see rules on reverse side)

Starting Date:2...10...86.....
month day year

CHANGE OF OPERATOR

API Number ~~15~~

153-20,625-00-00 CORRECTION 1-2-86

East

NE NE SE. ... Sec .32. Twp .3S. S, Rge .36. West
(location)

* OPERATOR: License # 4248.....

NameJDP..Corp.....

Address1616.Glenarm.Pl.,.Suite.1804..

City/State/Zip ...Denver.,.CO...80202.....

Contact Person .John.Pruit.....

Phone ..303/534-4781.....

CONTRACTOR: License # 6033.....

NameMurfin.Drilling.....

City/StateWichita.,.Kansas.....

.2310..... Ft North from Southeast Corner of Section

...330..... Ft West from Southeast Corner of Section

(Note: Locate well on Section Plat on reverse side)

Nearest lease or unit boundary line330..... feet.

CountyRawlins.....

Lease Name ...Officer..... * Well# ..32-43A.

Domestic well within 330 feet: yes no

Municipal well within one mile: yes no

Well Drilled For: Well Class: Type Equipment:

- Oil Swd Infield Mud Rotary
- Gas Inj Pool Ext. Air Rotary
- OWWO Expl Wildcat Cable

Depth to Bottom of fresh water350..... feet

Lowest usable water formationOgallala.....

Depth to Bottom of usable water350..... feet

Surface pipe by Alternate: 1 2

Surface pipe to be set400..... feet

Conductor pipe if any required77..... feet

Ground surface elevation3311..... feet MSL

This Authorization Expires2-12-86.....

Approved By8-12-85.....

If OWWO: old well info as follows:

Operator

Well Name

Comp Date Old Total Depth

Projected Total Depth4800..... feet

Projected Formation at TDCherokee.....

Expected Producing Formations Cherokee.,.Lansing.....


I certify that we will comply with K.S.A. 55-101, et seq., plus eventually plugging hole to K.C.C. specifications. *was Glynbelg Pet. Co.*

Date 1/15/86..... Signature of Operator or Agent *John D. Pruit* Title President # 118".....

**Must be filed with the K.C.C. five (5) days prior to commencing well
This card void if drilling not started within six (6) months of date received by K.C.C.**

Important procedures to follow :

**A Regular Section of Land
1 Mile = 5,280 Ft.**

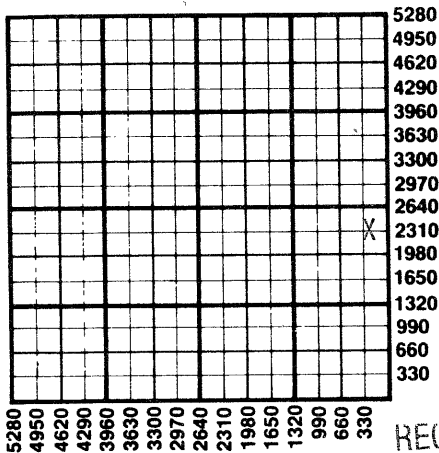

1. Notify District office before setting surface casing.
2. Set surface casing by circulating cement to the top.
3. File completion forms ACO-1 with K.C.C. within 90 days of well completion, following instructions on ACO-1, side 1, and including copies of wireline logs.
4. Notify District office 48 hours prior to old well workover or re-entry.
5. Prior to plugging, prepare a plugging plan, then obtain agreement from the appropriate district office for an approved plugging plan.
6. Submit plugging report (CP-4) to K.C.C. after plugging is completed.
7. Obtain an approved injection docket number before disposing of salt water.
8. Notify K.C.C. within 10 days when injection commences or terminates.
9. If an alternate 2 completion, cement in the production pipe from below any usable water to surface within 120 days of spud date.

RECEIVED
STATE CORPORATION COMMISSION

JAN 17 1986
CONSERVATION DIVISION

1-17-86

State Corporation Commission of Kansas
Conservation Division
200 Colorado Derby Building
Wichita, Kansas 67202
(316) 263-3238