


15-023-19003-0000

STATE OF KANSAS
STATE CORPORATION COMMISSION

Give All Information Completely
Make Required Affidavit
Mail or Deliver Report to:
Conservation Division
State Corporation Commission
211 No. Broadway
Wichita, Kansas

R
WELL PLUGGING RECORD

Cheyenne County, Sec. 13 Twp. 3 Rge. 42 (E) (W) X
Location as "NE/CNW/SW" or footage from lines Center of SE ~~SW~~ NE
Lease Owner Herman Geo. Kaiser
Lease Name John Reub Well No. #1
Office Address 909 Palace Bldg., Tulsa, Oklahoma
Character of Well (completed as Oil, Gas or Dry Hole) _____
Date well completed _____ 19____
Application for plugging filed _____ 19____
Application for plugging approved _____ 19____
Plugging commenced 6-21-63 19____
Plugging completed 6-25-63 19____
Reason for abandonment of well or producing formation _____

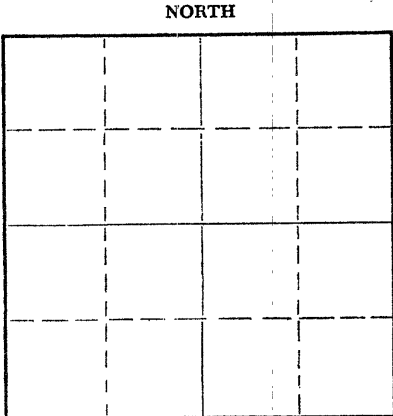

Locate well correctly on above Section Plat

If a producing well is abandoned, date of last production _____ 19____
Was permission obtained from the Conservation Division or its agents before plugging was commenced? _____

Name of Conservation Agent who supervised plugging of this well W. L. Nichols
Producing formation _____ Depth to top _____ Bottom _____ Total Depth of Well 5513' Feet
Show depth and thickness of all water, oil and gas formations.

OIL, GAS OR WATER RECORDS

CASING RECORD

FORMATION	CONTENT	FROM	TO	SIZE	PUT IN	PULLED OUT

Describe in detail the manner in which the well was plugged, indicating where the mud fluid was placed and the method or methods used in introducing it into the hole. If cement or other plugs were used, state the character of same and depth placed, from _____ feet to _____ feet for each plug set.

Sanded back to 4525'. Mixed and ran 5 sacks cement thru dump bailor.
Circulated hole with 15 sacks gel and spotted 20 sacks cement thru 5 1/2" casing at 600'. Pulled 11 joints. Spotted 20 sacks cement thru 5 1/2" casing at 225'. Pulled 7 joints. Mudded hole to 40' - set 10' rock bridge. Mixed and dumped 10 sacks cement to base of cellar.

RECEIVED
STATE CORPORATION COMMISSION

JUN 28 1963

CONSERVATION DIVISION
Wichita, Kansas

6-28-63

(If additional description is necessary, use BACK of this sheet)

Name of Plugging Contractor Southwest Casing Pulling Co., Inc.
Address Box 364, Great Bend, Kansas

STATE OF Kansas, COUNTY OF Barton, ss.
Southwest Casing Pulling Co., Inc. (employee of owner) or (owner or operator) of the above-described well, being first duly sworn on oath, says: That I have knowledge of the facts, statements, and matters herein contained and the log of the above-described well as filed and that the same are true and correct. So help me God.

(Signature) W. C. Spencer Sec.
Box 364, Great Bend, Kansas
(Address)

SUBSCRIBED AND SWORN TO before me this 27 day of June, 1963

My commission expires 21 October 1964 Siding D Miller Notary Public.

INVOICED
DATE 6/28/63
INV. NO. 7329-4

MCNEIL AND ROBERTS
GEOLOGISTS

202 PARAMOUNT BUILDING
1631 GLENARM PLACE
DENVER 2, COLORADO
AM 6-2931

19003
15-023-2000-00-00

TOM N. ROBERTS
RES. PHONE BE 7-2619

HAROLD E. MCNEIL
RES. PHONE HA 4-3812

December 10, 1958

R. G. LAWTON #1 RUBB
C SE NE SECTION 13-38-42N
CHEYENNE COUNTY, KANSAS

ELEVATION 3632 Ground (County engineer)
3640 Derrick floor
3643 Kelly bushing

CONTRACTOR Falcon-Seaboard Drilling Co. Rig #20

COMMENCED November 12, 1958

COMPLETED Schlumberger survey on December 3, 1958

CASING 10 3/4" cemented at 240' with 175 sax
Recommended cementing 5 1/2" at approximately 4755'

FORMATION TOPS

Miobrara	1565	(+2078)	
Fort Hays	2053	(+1590)	
Carlile	2143	(+1500)	
Greenhorn	2340	(+1303)	
Dakota	2535	(+1108)	
Fuson	2718	(+ 925)	
Lakota	2847	(+ 796)	
Morrison	3105	(+ 538)	
Blaine	3299	(+ 344)	
Stens Corral	3483	(+ 160)	
Fort Riley	3658	(- 15)	
Neva	3934	(- 291)	
Foraker	4059	(- 416)	
Howard	4279	(- 636)	
Topoka	4322	(- 679)	
Lansing	4593	(- 950)	
Base Kansas City	4793	(-1150)	
Marmaton	4810	(-1167)	
Cherokee	4985	(-1342)	
Morrow	5172	(-1529)	
Mississippian	5310	(-1667)	
Arbuckle	5431	(-1788)	
Total depth	5513	(-1870)	- Driller
	5512	(-1869)	- Schlumberger

RECEIVED
STATE CORPORATION COMMISSION

AUG 5 1963
8-5-63
CONSERVATION DIVISION
Wichita, Kansas

OFFICE PHONES (LU 3-3413
(LU 4-6358
RES. PH. RI 7-7116
AREA CODE 918

WICHITA KANSAS OFFICE
601 UNION CENTER
PHONE HOBART 4-8495
AREA CODE 316

15-023-19003
-00-00

Herman Geo. Kaiser, Oil Producer

909 PALACE BUILDING

Tulsa 3, Oklahoma

August 2, 1963

RECEIVED
STATE CORPORATION COMMISSION

AUG 5 1963

8-5-63
CONSERVATION DIVISION
Wichita, Kansas

State Corporation Commission
Conservation Division
500 Insurance Building
Wichita, Kansas

Gentlemen:

Re: #1 Rueb
C SE NE Section 13-T3S-R42W
Cheyenne County, Kansas

Enclosed is the pertinent well log information you requested in your form letter of August 1, 1963.

We purchased this property from the Janlyn Oil Company, Inc., Magnolia, Arkansas and did not receive a "formal" well log at the time of purchase.

Yours very truly,

HERMAN GEORGE KAISER, OIL PRODUCER


F. Hitchens

enclosure 1