

EFFECTIVE DATE:

DISTRICT # 4

SEAT Yes No

State of Kansas

NOTICE OF INTENTION TO DRILL

Must be approved by the K.C.C. five (5) days prior to commencing well

Expected Spud Date 12/17/93 month day year

Spot SE SW SW Sec 26 Twp 3 S, Rg 42 East West

OPERATOR: License # 31219 Name: Prime Operating Company Address: 731 W. Wadley, L-220 City/State/Zip: Midland, TX 79705 Contact Person: H.G. Livingston/Irene C. Rosas Phone: 915/682-5600

337 feet from South / North Line of Section 991 feet from East / West Line of Section IS SECTION X REGULAR IRREGULAR

(NOTE: Locate well on the Section Plat on Reverse Side)

County: Cheyenne

Lease Name: Zwegardt Well #: 26-13-1

Field Name: Wildcat

Is this a Prorated/Spaced Field? yes X no

Target Formation(s): Niobrara

Nearest lease or unit boundary: 337'

Ground Surface Elevation: 3707 feet MSL

Water well within one-quarter mile: yes X no

Public water supply well within one mile: yes X no

Depth to bottom of fresh water: 210'

Depth to bottom of usable water: 290'

Surface Pipe by Alternate: X 1

Length of Surface Pipe Planned to be set: 320 (340)'

Length of Conductor pipe required: None

Projected Total Depth: 1800'

Formation at Total Depth: Niobrara

Water Source for Drilling Operations: well farm pond X other

DWR Permit #: Will Cores Be Taken? yes X no

If yes, proposed zone: or to a depth sufficient to

penetrate 50' into the Blue

Shale, whichever is deeper.

and eventual plugging of this well will comply with U.S.A. 55-

101, et. seq.

It is agreed that the following minimum requirements will be met:

RECEIVED KANSAS CORPORATION COMMISSION

DEC 08 1993 CONSERVATION DIVISION WICHITA, KS

- 1. Notify the appropriate district office prior to spudding of well;
2. A copy of the approved notice of intent to drill shall be posted on each drilling rig;
3. The minimum amount of surface pipe as specified below shall be set by circulating cement to the top...
4. If the well is dry hole, an agreement between the operator and the district office on plug length and placement is necessary prior to plugging;
5. The appropriate district office will be notified before well is either plugged or production casing is cemented in;
6. IF AN ALTERNATE IS COMPLETED, PRODUCTION PIPE SHALL BE CEMENTED FROM BELOW ANY USABLE WATER TO SURFACE WITHIN 120 DAYS OF SPUD DATE. IN ALL CASES, NOTIFY DISTRICT OFFICE PRIOR TO ANY CEMENTING.

I hereby certify that the statements made herein are true and to the best of my knowledge and belief.

Date: 12/7/93 Signature of Operator or Agent: Irene C. Rosas Title: Production Clerk

FOR KCC USE: API # 15- 023-20338-00-00 Conductor pipe required NONE feet Minimum surface pipe required 320 feet per Alt. Approved by: CB 12-9-93 This authorization expires: 6-9-94 (This authorization void if drilling not started within 6 months of effective date.) Spud date: Agent:

REMEMBER TO:

- File Drill Pit Application (form CDP-1) with Intent to Drill;
- File Completion Form ACD-1 within 120 days of spud date;
- File acreage attribution plat according to field preparation orders;
- Notify appropriate district office 48 hours prior to workover or re-entry;
- Submit plugging report (CP-4) after plugging is completed;
- Obtain written approval before disposing or injecting salt water.

Mail to: Conservation Division, 200 Colorado Derby Building, 202 W. First St., Wichita, Kansas 67202-1236.

Handwritten numbers 26, 3, 42 on the right margin.

IN ALL CASES PLOT THE INTENDED WELL ON THE PLAT BELOW.

PLAT OF ACREAGE ATTRIBUTABLE TO A WELL IN A PRORATED OR SPACED FIELD

If the intended well is in a prorated or spaced field, please fully complete this side of the form. If the intended well is in a prorated or spaced field complete the plat below showing that the well will be properly located in relationship to other wells producing from the common source of supply. Please show all the wells within 1 mile of the boundaries of the proposed acreage attribution unit for gas wells and within 1/2 mile of the boundaries of the proposed acreage attribution unit for oil wells.

API NO. 15- _____
 OPERATOR Prime Operating Company
 LEASE Zweygardt
 WELL NUMBER 26-13-1
 FIELD Wildcat

LOCATION OF WELL: COUNTY Cheyenne
337 feet from south/north line of section
991 feet from east/west line of section
 SECTION 26 TWP 3S RG 42W



NUMBER OF ACRES ATTRIBUTABLE TO WELL 10
 QTR/QTR/QTR OF ACREAGE SE - SW - SW

IS SECTION _____ REGULAR or _____ IRREGULAR
 IF SECTION IS IRREGULAR, LOCATE WELL FROM NEAREST
 CORNER BOUNDARY.

Section corner used: _____ NE _____ NW _____ SE _____ SW

PLAT

(Show location of the well and shade attributable acreage for prorated or spaced wells.)
 (Show footage to the nearest lease or unit boundary line.)

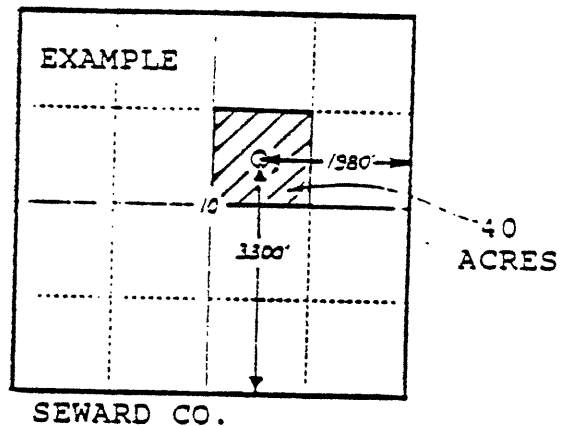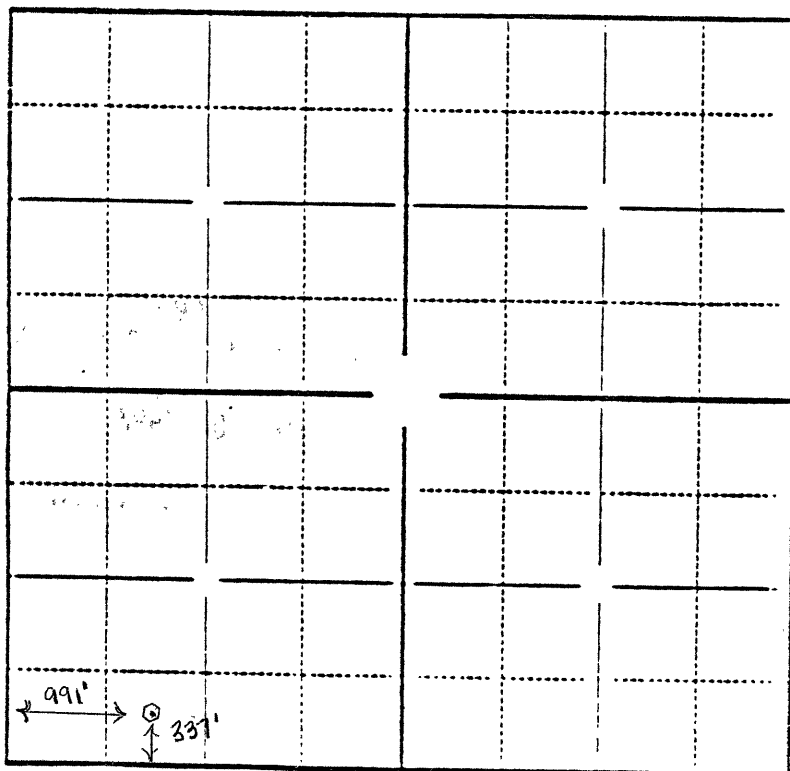

In plotting the proposed location of the well, you must show:

- 1) The manner in which you are using the depicted plat by identifying section lines, i.e. 1 section, 1 section with 8 surrounding sections, 4 sections, etc.;
- 2) the distance of the proposed drilling location from the section's south/north and east/west lines; and
- 3) the distance to the nearest lease or unit boundary line.