

For KCC Use: Effective Date: 9-22-04 District # 2 SGA? Yes No

KANSAS CORPORATION COMMISSION OIL & GAS CONSERVATION DIVISION

OWWO

Form C-1 December 2002 Form must be Typed Form must be Signed All blanks must be Filled

NOTICE OF INTENT TO DRILL

Must be approved by KCC five (5) days prior to commencing well

Expected Spud Date SEPTEMBER 20, 2004

OPERATOR: License# 5446 Name: BEN GILES Address: 532 SOUTH MARKET City/State/Zip: WICHITA, KS 67202 Contact Person: BEN GILES Phone: 316-265-1992

CONTRACTOR: License# 9/30/05 Name: C-G DRILLING LIC. #32701

Spot SW - SW - NW Sec. 35 Twp. 25 S. R. 1 East West 2310 feet from N / S Line of Section 330 feet from E / W Line of Section Is SECTION Regular Irregular?

(Note: Locate well on the Section Plat on reverse side)

County: SEDGWICK Lease Name: NEWCOMER Well #: 1B Field Name: HALEY

Is this a Prorated / Spaced Field? Yes No Target Information(s): Arbuckle - Granite Wash

Nearest Lease or unit boundary: 330 FT Ground Surface Elevation: 1394RB feet MSL

Water well within one-quarter mile: Yes No Public water supply well within one mile: Yes No

Depth to bottom of fresh water: 180 150 Depth to bottom of usable water: 150 180

Surface Pipe by Alternate: 1 2 Length of Surface Pipe ~~Planned to be set~~: 206' IN PLACE

Length of Conductor Pipe required: NONE Projected Total Depth: 3600

Formation at Total Depth: ARBUCKLE Water Source for Drilling Operations: Well Farm Pond Other HAULED

DWR Permit #: _____ (Note: Apply for Permit with DWR)

Will Cores be taken? Yes No If Yes, proposed zone: _____

Well Drilled For: Oil Gas OWO Seismic; # of Holes Other Well Class: Enh Rec Storage Disposal Pool Ext. Wildcat Other Type Equipment: Mud Rotary Air Rotary Cable

If OWWO: old well information as follows: Operator: O A SUTTON Well Name: #1 NEWCOMER Original Completion Date: 11/21/58 Original Total Depth: 3595

Directional, Deviated or Horizontal wellbore? Yes No

If Yes, true vertical depth: _____

Bottom Hole Location: RECEIVED KANSAS CORPORATION COMMISSION

KCC DKT #: _____

SEP 16 2004

AFFIDAVIT

The undersigned hereby affirms that the well, completion and eventual plugging of this well will comply with K.S.A. 55 et. seq. It is agreed that the following minimum requirements will be met:

- 1. Notify the appropriate district office prior to spudding of well;
2. A copy of the approved notice of intent to drill shall be posted on each drilling rig;
3. The minimum amount of surface pipe as specified below shall be set by circulating cement to the top; In all cases surface pipe shall be set through all unconsolidated materials plus a minimum of 20 feet into the underlying formation.
4. If the well is dry hole, an agreement between the operator and the district office on plug length and placement is necessary prior to plugging;
5. The appropriate district office will be notified before well is either plugged or production casing is cemented in;
6. If an ALTERNATE II COMPLETION, production pipe shall be cemented from below any usable water to surface within 120 days of spud date. Or pursuant to Appendix "B" - Eastern Kansas surface casing order #133,891-C, which applies to the KCC District 3 area, alternate II cementing must be completed within 30 days of the spud date or the well shall be plugged. In all cases, NOTIFY district office prior to any cementing.

I hereby certify that the statements made herein are true and to the best of my knowledge and belief.

Date: 9-15-04 Signature of Operator or Agent: [Signature] Title: Owner Operator

For KCC Use ONLY API # 15 - 173-00089.00-01 Conductor pipe required NONE feet Minimum surface pipe required 206 feet per Alt. 1 Approved by: RJP 9-17-04 This authorization expires: 3/17/04 (This authorization void if drilling not started within 6 months of effective date.) Spud date: _____ Agent: _____

Remember to:

- File Drill Pit Application (form CDP-1) with Intent to Drill;
- File Completion Form ACO-1 within 120 days of spud date;
- File acreage attribution plat according to field proration orders;
- Notify appropriate district office 48 hours prior to workover or re-entry;
- Submit plugging report (CP-4) after plugging is completed;
- Obtain written approval before disposing or injecting salt water.
- If this permit has expired (See: authorized expiration date) please check the box below and return to the address below.

Well Not Drilled - Permit Expired Signature of Operator or Agent: _____ Date: _____

Mail to: KCC - Conservation Division 50 S. Market - Room 2078, Wichita, Kansas 67202

35 25 1E

IN ALL CASES PLOT THE INTENDED WELL ON THE PLAT BELOW

Plat of acreage attributable to a well in a prorated or spaced field

If the intended well is in a prorated or spaced field, please fully complete this side of the form. If the intended well is in a prorated or spaced field complete the plat below showing that the well will be properly located in relationship to other wells producing from the common source of supply. Please show all the wells and within 1 mile of the boundaries of the proposed acreage attribution unit for gas wells and within 1/2 mile of the boundaries of the proposed acreage attribution unit for oil wells.

API No. 15 - _____
 Operator: _____
 Lease: _____
 Well Number: _____
 Field: _____
 Number of Acres attributable to well: _____
 QTR / QTR / QTR of acreage: _____ - _____ - _____

Location of Well: County: SEDGWICK
2310 feet from N / S Line of Section
330 feet from E / W Line of Section
 Sec. 35 Twp. 25 S. R. 1 East West



Is Section: Regular or Irregular

If Section is Irregular, locate well from nearest corner boundary.
 Section corner used: NE NW SE SW

PLAT

(Show location of the well and shade attributable acreage for prorated or spaced wells.)

(Show footage to the nearest lease or unit boundary line.)

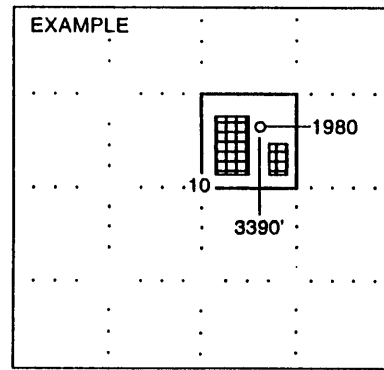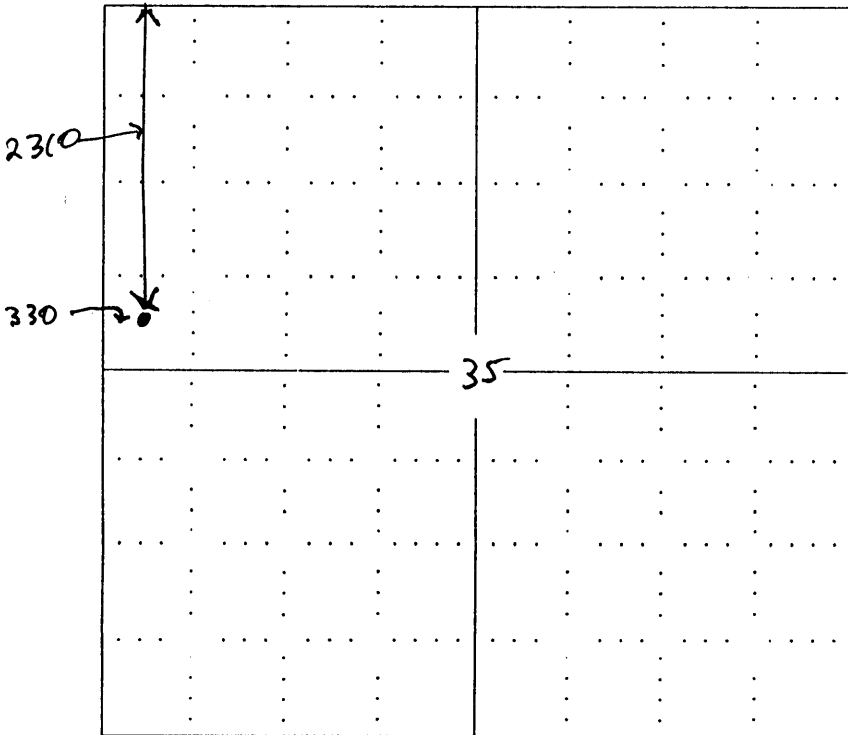

SEWARD CO.

NOTE: In all cases locate the spot of the proposed drilling locaton.

In plotting the proposed location of the well, you must show:

1. The manner in which you are using the depicted plat by identifying section lines, i.e. 1 section, 1 section with 8 surrounding sections, 4 sections, etc.
2. The distance of the proposed drilling location from the section's south / north and east / west.
3. The distance to the nearest lease or unit boundary line.
4. If proposed location is located within a prorated or spaced field a certificate of acreage attribution plat must be attached: (CO-7 for oil wells; CG-8 for gas wells).