


Give All Information Completely
Make Required Affidavit
Mail or Deliver Report to:
Conservation Division
State Corporation Commission
211 No. Broadway
Wichita, Kansas

WELL PLUGGING RECORD

NORTH

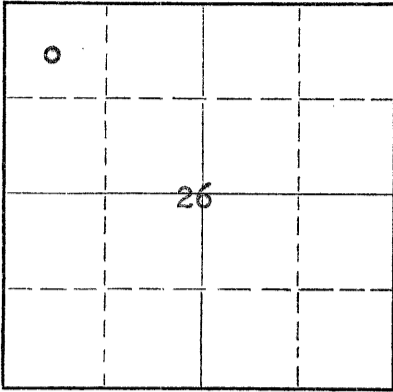

Locate well correctly on above
Section Plat

Cheyenne County. Sec. 26 Twp. 3S Rge. 42 (W)
Location as "NE/CNW/SW" or footage from lines 100' E & 75' S, Cen. NW NW
Lease Owner Sun Oil Company
Lease Name H. Richers Well No. 1
Office Address Box 1348, Tulsa, Oklahoma
Character of Well (completed as Oil, Gas or Dry Hole) Dry
Date well completed 5-30 19 59
Application for plugging filed 5-30 19 59
Application for plugging approved 5-30 19 59
Plugging commenced 5-30 19 59
Plugging completed 5-30 19 59
Reason for abandonment of well or producing formation Dryhole

If a producing well is abandoned, date of last production _____ 19 ____
Was permission obtained from the Conservation Division or its agents before plugging was commenced? yes

Name of Conservation Agent who supervised plugging of this well Mr. Fabricus, Hill City, Kansas
Producing formation none Depth to top _____ Bottom _____ Total Depth of Well 5350 Feet
Show depth and thickness of all water, oil and gas formations.

OIL, GAS OR WATER RECORDS

CASING RECORD

FORMATION	CONTENT	FROM	TO	SIZE	PUT IN	PULLED OUT
Lansing Lime	DST 4505-48 rec. 20' oil cut mud	4443	4540	8-5/8"	291.44	none
Morrow Sand	DST 5188- 5223' rec. 2700' salt water	5188	5230			

Describe in detail the manner in which the well was plugged, indicating where the mud fluid was placed and the method or methods used in introducing it into the hole. If cement or other plugs were used, state the character of same and depth placed, from _____ feet to _____ feet for each plug set.

20 sax cement plug 600'-540' (spotted w/drill pipe)
20 sax cement plug 290'-230' (spotted w/drill pipe)
Pushed HOWCO plug to 40' and spotted 10 sax cement 40'-10'
5 sax cement cap placed in top of 8-5/8"

RECEIVED
STATE CORPORATION COMMISSION

JUN 26 1959

CONSERVATION DIVISION
Wichita, Kansas

15-26-59
6

(If additional description is necessary, use BACK of this sheet)

Name of Plugging Contractor Jelly Reaves Drilling Co.
Address Box 1264, Cushing, Oklahoma

STATE OF OKLAHOMA, COUNTY OF TULSA, ss.
J. H. Allen (employee of owner) or (owner or operator) of the above-described

well, being first duly sworn on oath, says: That I have knowledge of the facts, statements, and matters herein contained and the log of the above-described well as filed and that the same are true and correct. So help me God.

(Signature) J. H. Allen
J. H. Allen,

(Address)

SUBSCRIBED AND SWORN TO before me this 26 day of June, 19 59

Dorothy Little
Notary Public.

My commission expires July 25, 1962

PLUGGING
FILE SEC. 26 T. 3 R. 42W
BOOK PAGE 48 LINE 10

DRILLERS' LOG

15-023-00011-00-00

SUN OIL COMPANY
Richers No. 1
NW/4 NW/4

Sec. 26, Twp. 3S, Rge. 42W
Cheyenne County, Kansas

FORMATION	FROM	TO
Sand and shale	0	308
Shale	308	1468
Sand and shale (Niobrara)	1468	2070
Shale (Carlile)	2070	2260
Lime (Greenhorn)	2260	2295
Shale	2295	2458
Lime, sand, shale (Dakota)	2458	2640
Shale (Fuson)	2640	2763
Sand (Lakota)	2763	2880
Shale	2880	2928
Sand & shale (Cheyenne)	2928	3040
Shale (Morrison)	3040	3258
Lime & shale	3258	3560
Sand, shale, lime	3560	3900
Lime and shale	3900	4042
Lime (Foraker)	4042	4080
Shale and lime	4080	4302
Lime and shale	4302	4443
Lime (Lansing)	4443	4540
Lime and shale	4540	4692
Sand	4692	4718
Lime and shale	4718	4832
Sand	4832	4854
Lime and shale (Marmaton)	4854	4992
Shale & Lime (Cherokee)	4992	5106
Sand (Morrow)	5106	5128
Shale	5128	5188
Lime and shale	5188	5245
Lime (Miss.)	5245	5330
		T.D.

Elev. DF 3659'. Grd. 3653.35'.

CASING RECORD:

8-5/8" J55 24# csg., 291.44' set at 303', cemented to ground level with 300 sax.

CORES:

- #1: 4490-4548' rec. 58':
15' lmy. shale & shly. ls.
9' ls. w/scattered show oil
14' dense ls.
9' cherty ls., show oil in frac.
11' lmy. foss. shale
- #2: 5186-5233' rec. 44' sand, shale, conglomerate, limestone, no show.

D.S.T.

- #1: 4505-4548' open 1 1/2 hrs., rec. 20' oil cut mud, BHP 1145#.
- #2: 5188-5233' open 1 hr., rec. 2700' salt water, BHP 1170#.

RECEIVED
STATE CORPORATION COMMISSION
JUN 26 1959
7-26-59

I hereby certify that the foregoing is a true and correct copy of the Richers No. 1 well log as recorded on the books of Sun Oil Company, Tulsa, Oklahoma.

J. H. Allen
J. H. Allen, Asst. Prod. Supt.

STATE OF OKLAHOMA)
) SS
COUNTY OF TULSA)

Subscribed and sworn to before me this 26 day of ^{June}~~May~~, 1959.

Dorothy Little
Notary Public

My Commission Expires:
JUL 25 1962

PLUGGING
FILE SEC. 26 T. 3 R. 42W
BOOK PAGE 48 LINE 12