


STATE OF KANSAS
STATE CORPORATION COMMISSION

Give All Information Completely
Make Required Affidavit
Mail or Deliver Report to:
Conservation Division
State Corporation Commission
212 North Market, Insurance Bldg.
Wichita, Kansas

15-023-00020-00-00
WELL PLUGGING RECORD

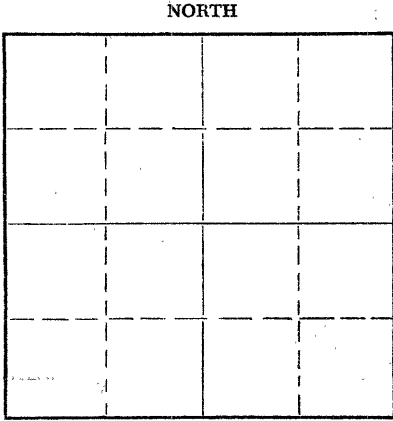

Locate well correctly on above
Section Plat

Cheyenne County. Sec. 36 Twp. 3 Rge. 42 (E) (W)
Location as "NE/CNW $\frac{1}{4}$ SW $\frac{1}{4}$ " or footage from lines CNW/2 NE74
Lease Owner Herman George Kaiser
Lease Name Liebbrant Well No. 1
Office Address Ellinwood, Kansas
Character of Well (completed as Oil, Gas or Dry Hole)
Date well completed 19
Application for plugging filed 19
Application for plugging approved 19
Plugging commenced 6-2 19 61
Plugging completed 6-9 19 61
Reason for abandonment of well or producing formation

If a producing well is abandoned, date of last production 19
Was permission obtained from the Conservation Division or its agents before plugging was commenced? Yes

Name of Conservation Agent who supervised plugging of this well Gilbert Leiker
Producing formation Depth to top Bottom Total Depth of Well 5300 Feet
Show depth and thickness of all water, oil and gas formations.

OIL, GAS OR WATER RECORDS

CASING RECORD

FORMATION	CONTENT	FROM	TO	SIZE	PUT IN	PULLED OUT
				8 5/8	2251	None
				5 1/2	4631	2106

Describe in detail the manner in which the well was plugged, indicating where the mud fluid was placed and the method or methods used in introducing it into the hole. If cement or other plugs were used, state the character of same and depth placed, from feet to feet for each plug set.

Plug @ 4562
Top Perforation 4505

Sanded to 4490' - dumped 5 sks cement - pulled casing -
mudded hole to 230' - set 10' rock bridge - dumped 25 sks
cement - mudded hole to 35' - set 5' rock bridge -
dumped 10 sks cement

RECEIVED
STATE CORPORATION COMMISSION

AUG 17 1961

CONSERVATION DIVISION
Wichita, Kansas

8-17-61

Name of Plugging Contractor R & D Casing Pulling Co License # 236
Address Box # 572, Hutchinson, Kansas

STATE OF KANSAS, COUNTY OF BARTON, ss.
W. S. HALL (employee of owner) or (owner or operator) of the above-described

well, being first duly sworn on oath, says: That I have knowledge of the facts, statements, and matters herein contained and the log of the above-described well as filed and that the same are true and correct. So help me God.

(Signature)

(Address)

SUBSCRIBED AND SWORN TO before me this 16 day of AUGUST, 1961

My commission expires

Evelyn L. Miller
EVELYN L. MILLER, NOTARY PUBLIC Notary Public.
Commission Expires Feb. 25, 1963

15-023-00020-00-00

WELL LOG BUREAU—KANSAS GEOLOGICAL SOCIETY
508 East Murdock, Wichita, Kansas


COPY

Company. R. G. LAWTON
Farm- Leibbrandt No. 1

SEC. 36 T. 3 R. 42W
C NW NE

Total Depth. 5300'
Comm. 12-1-59 Comp. 12-11-59
Shot or Treated.
Contractor. Jolly Reaves Drig.
Issued. 7-22-61

County Cheyenne
KANSAS

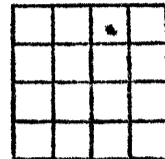

CASING:
8" 225'
5" 4631'

Elevation. 3649'

Production. 95 BOPD

Figures Indicate Bottom of Formations.

COMPLETE DRILLERS LOG NOT AVAILABLE:

TOPS: SCOUT	
Topeka	4302
Lansing	4445
Base Kansas City	4776
Cherokee	4974
Cherokee Sand	5204
Mississippi	5250
Total Depth	5300