

WELL PLUGGING RECORD

Give All Information Completely
Make Required Affidavit
Mail or Deliver Report to:
Conservation Division
State Corporation Commission
211 No. Broadway
Wichita, Kansas

Cheyenne County, Sec. 4 Twp. 3S Rge. (X) 41(W)

Location as "NE/CNW%SW%" or footage from lines 600' FSL and 1980' FWL

Lease Owner J-W Operating Company, 1900 LTV Tower, Dallas, TX 75201

Lease Name Ruben Walter Well No. 4

Office Address see above

Character of Well (completed as Oil, Gas or Dry Hole) dry hole

Date well completed September 4 1980

Application for plugging filed 19

Application for plugging approved 19

Plugging commenced September 4 1980


Plugging completed September 4 1980

Reason for abandonment of well or producing formation drilled a dry hole

If a producing well is abandoned, date of last production 19

Was permission obtained from the Conservation Division or its agents before plugging was commenced? yes--verbal

NORTH

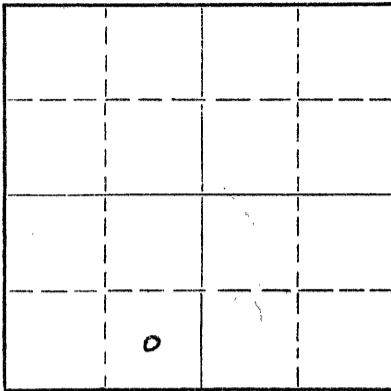

Locate well correctly on above Section Plat

Name of Conservation Agent who supervised plugging of this well

Producing formation Smokey Hills Chalk Depth to top 1498' Bottom 1540' Total Depth of Well 1596' Feet

Show depth and thickness of all water, oil and gas formations.

OIL, GAS OR WATER RECORDS

CASING RECORD

FORMATION	CONTENT	FROM	TO	SIZE	PUT IN	PULLED OUT
none						

Describe in detail the manner in which the well was plugged, indicating where the mud fluid was placed and the method or methods used in introducing it into the hole. If cement or other plugs were used, state the character of same and depth placed, from _____ feet to _____ feet for each plug set.

circulated 8.9 #/gal. drilling mud to Total Depth
set 10 sacks, plug at bottom of surface casing from 207 ft. to 255 ft.
set 15 sacks, plug at surface from 5 ft. to 77 ft.
cut and welded cap on pipe 5 ft. below ground level

RECEIVED
STATE CORPORATION COMMISSION
MAR 16 1981
03-16-1981
CONSERVATION DIVISION
Wichita, Kansas

(If additional description is necessary, use BACK of this sheet)

Name of Plugging Contractor Excell Drilling Company

Address _____

STATE OF Colorado, COUNTY OF Yuma, ss. MARK D. WESTERMAN

(employee of owner) or (owner or operator) of the above-described well, being first duly sworn on oath, says: That I have knowledge of the facts, statements, and matters herein contained and the log of the above-described well as filed and that the same are true and correct. So help me God.

(Signature) Mark D. Westerman

PO Box 305, Wray, CO 80785 (Address)

SUBSCRIBED AND SWORN to before me this 11th day of March, 19 81

Donald L. Sherlock
DONALD L. SHERLOCK

My commission expires April 15, 1981

Notary Public.