

STATE OF KANSAS
STATE CORPORATION COMMISSION

WELL PLUGGING RECORD

Give All Information Completely
Make Required Affidavit
Mail or Deliver Report to
Conservation Division
State Corporation Comm.
245 North Water
Wichita, KS 67202

Cheyenne County. Sec. 4 Twp. 3S Rge. 41 ~~NE~~/W
Location as "NE/CNW $\frac{1}{4}$ SW $\frac{1}{4}$ " or footage from lines
SE SE SW

Lease Owner Shakespeare Oil

Lease Name Ruben Walter Well No. 1

Office Address Box 669, Salem, Ill., 62881

Character of Well (Completed as Oil, Gas or Dry Hole)
D&A

Date Well completed 10/29 1977

Application for plugging filed 10/29 1977

Application for plugging approved 10/29 1977

Plugging commenced 10/29 1977

Plugging completed 10/29 1977

Reason for abandonment of well or producing formation
D&A


If a producing well is abandoned, date of last production
19

Was permission obtained from the Conservation Division or
its agents before plugging was commenced? Yes

Name of Conservation Agent who supervised plugging of this well G. Balthezor

Producing formation Depth to top Bottom Total Depth of Well 4764'

Show depth and thickness of all water, oil and gas formations.

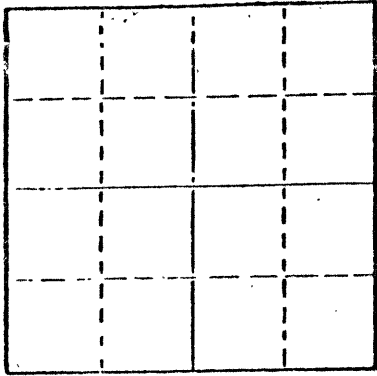

Locate well correctly on above
Section Plot

OIL, GAS OR WATER RECORDS

CASING RECORD

FORMATION	CONTENT	FROM	TO	SIZE	PUT IN	PULLED OUT
				8 5/8	252'	None

Describe in detail the manner in which the well was plugged, indicating where the mud fluid was placed and the method or methods used in introducing it into the hold. If cement or other plugs were used, state the character of same and depth placed, from feet to feet for each plug set.

1st plug @ 2000' w/70 sx
2nd plug @ 240' w/20 sx
3rd plug @ 40' w/10 sx

NOV 08 1977
11-08-1977

(If additional description is necessary, use BACK of this sheet)

Name of Plugging Contractor Halliburton

STATE OF Kansas COUNTY OF Sedgwick ss.

Wm. S. Shropshire (employee of owner) of the above-described

well, being first duly sworn on oath, says: That I have knowledge of the facts, statements, and matters herein contained and the log of the above-described well as filed and that the same are true and correct. So help me God.

(Signature) Wm. S. Shropshire

617 Union Center, Wichita, Ks 67202

(Address)

SUBSCRIBED AND SWORN TO before me this 7th day of November 1977

JOLENE S. FRISBIE, STATE NOTARY PUBLIC

My Comm. Exp. March 13, 1979

Jolene S. Frisbie
Notary Public.



WELL LOG

15-023-20038-00-00

COMPANY Shakespeare Oil

SEC. 4 T. 3S R. 41W
LOG. SE SE SW

FARM RUBEN WALTER NO. 1

RIG. NO. 7


TOTAL DEPTH 4764'

COUNTY Cheyenne, Ks
KANSAS

COMM. 10/22/77

COMP. 10/29/77

CONTRACTOR Murfin Drilling

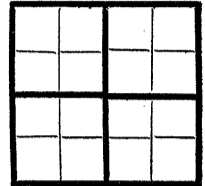

CASING

20 10
15 85/8 @ 252' w/225 sx
12 6
13 5

ELEVATION

PRODUCTION D&A

FIGURES INDICATE BOTTOM OF FORMATIONS

sand, clay 220
shale 252
shale, sand 3060
sand, lime w/pyrite 3163
shale, lime 3887
lime 4005
lime, shale 4440
lime 4764
RTD 4774

NOV 1977

State of Kansas }
County of Sedgwick } ss:

I, Wm. S. Shropshire of the Murfin Drilling Company

upon oath state that the above and foregoing is a true and correct copy of the log of the Ruben Walter #1 well.

Wm S Shropshire

Subscribed and sworn to before me this 7th day of November 19 77

JOLENE S. FRISBIE, STATE NOTARY PUBLIC

My Commission Expires: My Comm. Exp. March 13, 1979

Jolene S. Frisbie
NOTARY PUBLIC