


WELL PLUGGING RECORD

Give All Information Completely
Make Required Affidavit
Mail or Deliver Report to:
Conservation Division
State Corporation Commission
212 No. Market
Wichita, Kansas

NORTH

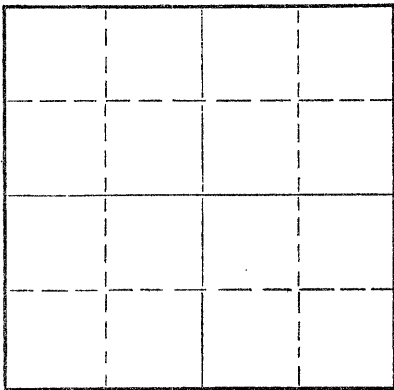

Locate well correctly on above Section Plat

Phillips County. Sec. 7 Twp. 4S Rge. 18 (E) W (W)
Location as "NE/CNW/SW" or footage from lines NW SE NW
Lease Owner Don H. Peaker, et al.
Lease Name August Eikhoff Well No. 1
Office Address Bon Durant Building, Pueblo, Colorado
Character of Well (completed as Oil, Gas or Dry Hole) D&A
Date well completed August 27, 1969
Application for plugging filed August 27, 1969
Application for plugging approved August 27, 1969
Plugging commenced August 27, 1969
Plugging completed August 27, 1969
Reason for abandonment of well or producing formation D&A

If a producing well is abandoned, date of last production _____ 19____
Was permission obtained from the Conservation Division or its agents before plugging was commenced? Yes

Name of Conservation Agent who supervised plugging of this well Leo F. Massey
Producing formation _____ Depth to top _____ Bottom _____ Total Depth of Well 3430 Feet
Show depth and thickness of all water, oil and gas formations.

OIL, GAS OR WATER RECORDS

CASING RECORD

FORMATION	CONTENT	FROM	TO	SIZE	PUT IN	PULLED OUT
				8 5/8"	190.85'	-0-

Describe in detail the manner in which the well was plugged, indicating where the mud fluid was placed and the method or methods used in introducing it into the hole. If cement or other plugs were used, state the character of same and depth placed, from _____ feet to _____ feet for each plug set.

Plug #1 @ 720'
w/70 sx 50-50 poz,
6% total gel. Plug
#2 @ 180' w/same.
20 sx. Top plug @
40' w/same 10 sx.

RECEIVED
STATE CORPORATION COMMISSION
SEP 3 1969
CONSERVATION DIVISION
Wichita, Kansas

9-3-69

(If additional description is necessary, use BACK of this sheet)
Name of Plugging Contractor Red Tiger Drilling Company
Address 1720 Wichita Plaza, Wichita, Kansas 67202

STATE OF Kansas, COUNTY OF Sedgwick, ss.
Norman E. Klein (employee of owner) or (owner or operator) of the above-described well, being first duly sworn on oath, says: That I have knowledge of the facts, statements, and matters herein contained and the log of the above-described well as filed and that the same are true and correct. So help me God.

(Signature) Norman E. Klein
1720 Wichita Plaza, Wichita, Kansas 67202
(Address)

SUBSCRIBED AND SWORN to before me this 29th day of August, 1969

Gloria Sawcett
Notary Public.

