


15-147-00080-00-00

STATE OF KANSAS
STATE CORPORATION COMMISSION

WELL PLUGGING RECORD

Give All Information Completely
Make Required Affidavit
Mail or Deliver Report to:
Conservation Division
State Corporation Commission
800 Bittling Building
Wichita, Kansas

Phillips County. Sec. 10 Twp. 4S Rge. 18W (W)
Location as "NE/CNW $\frac{1}{4}$ SW $\frac{1}{4}$ " or footage from lines NE SW NW
Lease Owner National Associated Petroleum Company
Lease Name Vera Emerick Well No. 1
Office Address 5th Floor Ritz Bldg. - Tulsa, Oklahoma
Character of Well (completed as Oil, Gas or Dry Hole) Dry Hole
Date well completed 12-11-51 19. 51
Application for plugging filed December 11 19. 51
Application for plugging approved December 11 19. 51
Plugging commenced December 11 19. 51
Plugging completed December 12 19. 51
Reason for abandonment of well or producing formation

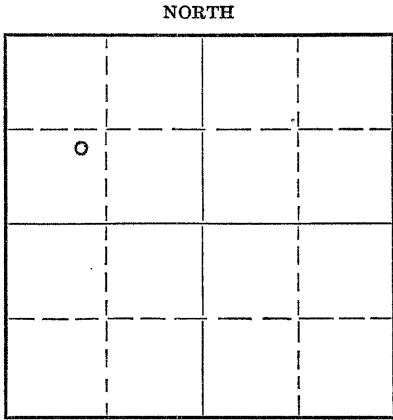

Locate well correctly on above
Section Plat

If a producing well is abandoned, date of last production 19.
Was permission obtained from the Conservation Division or its agents before plugging was commenced? Yes

Name of Conservation Agent who supervised plugging of this well Eldon Petty - Box 326 - Hays, Kansas
Producing formation Depth to top Bottom Total Depth of Well 3600 Feet
Show depth and thickness of all water, oil and gas formations.

OIL, GAS OR WATER RECORDS

CASING RECORD


Formation	Content	From	To	Size	Put In	Pulled Out
Topeka		2903	3109	8-5/8"	220'	None
Heebner		3109	3117			
Lansing-K.C.		3136	3381			
Arbuckle		3576	3599			

Describe in detail the manner in which the well was plugged, indicating where the mud fluid was placed and the method or methods used in introducing it into the hole. If cement or other plugs were used, state the character of same and depth placed, from feet to feet for each plug set.

Hole filled with mud to 200 feet.
Set wood plug w/ 1/2 sx C. S. Hulls & 15 sx cement @ 200 feet.
Finished filling hole to 30 feet from bottom of cellar.
Set wood plug w/ 1/2 sx C.S. hulls & 10 sx cement.
Completed @ 12:30 a.m. 12-12-51.

(If additional description is necessary, use BACK of this sheet)

Name of Plugging Contractor J. D. Ferrell Drilling Company
Address Great Bend, Kansas

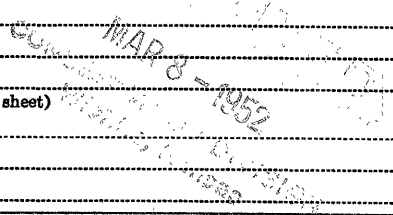

STATE OF Oklahoma COUNTY OF Tulsa, ss. 3-8-52
E. D. Ruse, (employee of owner) or (owner or operator) of the above-described well,
being first duly sworn on oath, says: That I have knowledge of the facts, statements, and matters herein contained and the log of the above-described well as filed and that the same are true and correct. So help me God.

(Signature) E. D. Ruse General Prod. Superintendent
5th Floor Ritz Bldg. - Tulsa, Oklahoma (Address)

SUBSCRIBED AND SWORN TO before me this 7th day of March, 1952.

Quiana McCormick Notary Public

My commission expires Jan. 13, 1956

