

15-147-00013-00-00

WELL PLUGGING RECORD

STATE OF KANSAS STATE CORPORATION COMMISSION

Give All Information Completely Make Required Affidavit Mail or Deliver Report to: Conservation Division State Corporation Commission 800 Bittig Building Wichita, Kansas


FORMATION PLUGGING RECORD

Strike out upper line when reporting plugging off formations.

OR

Phillips County. Sec. 6 Twp. 4 Rge. (E) 17 (W) Location as "NE 1/4 NW 1/4 SW 1/4" or footage from lines C E 1/2 SE 1/2 SE 1/2 Lease Owner Helmerich & Payne, Inc. et al Lease Name Loyd Well No. 1 Office Address Tulsa, Oklahoma Character of Well (completed as Oil, Gas or Dry Hole) Dry hole Date, well completed 6-13 1941 Application for plugging filed Verbal 6-13 1941 Application for plugging approved Verbal 6-13 1941 Plugging Commenced 6-13 1941 Plugging Completed 6-13 1941 Reason for abandonment of well or producing formation Dry hole

NORTH

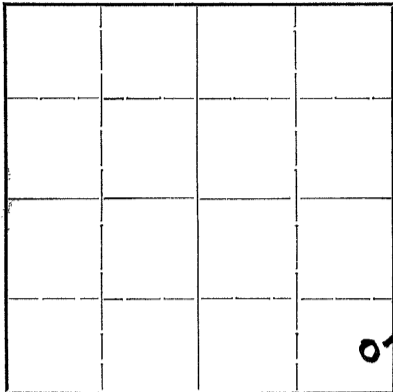

Locate well correctly on above Section Plat

If a producing well is abandoned, date of last production 19. Was permission obtained from the Conservation Division or its agents before plugging was commenced? Yes. Verbal

Name of Conservation Agent who supervised plugging of this well C. T. Alexander Producing formation None Depth to top Bottom Total Depth of Well 3830 Feet Show depth and thickness of all water, oil and gas formations.


OIL, GAS OR WATER RECORDS

CASING RECORD

Table with 7 columns: Formation, Content, From, To, Size, Put In, Pulled Out. Row 1: Arbuckle, Water, 3765, 3830, 8-5/8, 180, None.

Describe in detail the manner in which the well was plugged, indicating where the mud fluid was placed and the method or methods used in introducing it into the hole. If cement or other plugs were used, state the character of same and depth placed, from feet to feet for each plug set.

Ran drill pipe to bottom and circulated heavy rotary mud. Pulled drill pipe and circulated heavy mud at each 500 ft. point. Drove wooden plug to bottom of surface casing at 180 ft. Put in 1/2 yard chat. Dumped 15 sacks of cement on chat filling from 163 to 118. Filled to near top of surface casing with mud and placed cement cap of 5 sacks in top of surface casing.

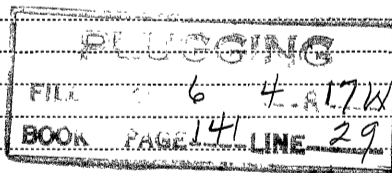

(If additional description is necessary, use BACK of this sheet)

Correspondence regarding this well should be addressed to Helmerich & Payne, Inc. Address 415 Philtower Building, Tulsa, Oklahoma

06-18-41

STATE OF COUNTY OF ss.

(employee of owner) or (owner or operator) of the above-described well, being first duly sworn on oath, says: That I have knowledge of the facts, statements, and matters herein contained and the log of the above-described well as filed and that the same are true and correct. So help me God.

(Signature)

Em Copeland 415 Philtower - Tulsa, Okla

(Address)

SUBSCRIBED AND SWORN to before me this 17th day of June, 1941

Lucie Griffin Notary Public.

My commission expires July 27, 1943



6-18-41