

15-183-00005-00-00

STATE OF KANSAS  
STATE CORPORATION COMMISSION


WELL PLUGGING RECORD

Give All Information Completely  
Make Required Affidavit  
Mail or Deliver Report to:  
Conservation Division  
State Corporation Commission  
800 Bitting Building  
Wichita, Kansas

Smith County. Sec. 28 Twp. 4 S Rge. 13 (E) W (W)

Location as "NE/CNW/SW" or footage from lines SE NE SW  
Lease Owner E. W. Whitney  
Lease Name Jacobs Well No. 1  
Office Address P.O. Box 600, Wewoka, Oklahoma  
Character of Well (completed as Oil, Gas or Dry Hole) Dry Hole  
Date well completed Sept. 15 1953  
Application for plugging filed Sept. 15 1953  
Application for plugging approved Sept. 15 1953  
Plugging commenced Sept. 15 1953  
Plugging completed Sept. 15 1953  
Reason for abandonment of well or producing formation Dry Hole

NORTH

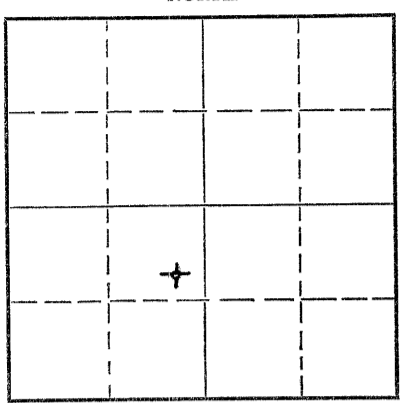

Locate well correctly on above  
Section Plat

If a producing well is abandoned, date of last production 19  
Was permission obtained from the Conservation Division or its agents before plugging was commenced? yes

Name of Conservation Agent who supervised plugging of this well C. D. Stough  
Producing formation \_\_\_\_\_ Depth to top \_\_\_\_\_ Bottom \_\_\_\_\_ Total Depth of Well 4200 Feet  
Show depth and thickness of all water, oil and gas formations.

OIL, GAS OR WATER RECORDS

CASING RECORD

FORMATION	CONTENT	FROM	TO	SIZE	PUT IN	PULLED OUT
		0	202	10 3/4	202	none

Describe in detail the manner in which the well was plugged, indicating where the mud fluid was placed and the method or methods used in introducing it into the hole. If cement or other plugs were used, state the character of same and depth placed, from \_\_\_\_\_ feet to \_\_\_\_\_ feet for each plug set.

From 4200' to 200' - heavy rotary mud and 1/2 sack hulls  
Drove Halliburton plug to 200'  
from 200' to 198 1/2' - wooden plug  
198 1/2' to 40' - 20 sacks cement and 1/2 sack hulls  
Drove Halliburton plug to 40'  
from 40' to 38 1/2' - wooden plug  
38 1/2' to 6' - cement to fill to bottom of cellar  
6' to surface - cellar

RECEIVED  
STATE CORPORATION COMMISSION  
OCT 27 1953  
CONSERVATION DIVISION  
WICHITA, KANSAS

Name of Plugging Contractor Glenn W. Peel  
Address P.O. Box 359, Hoisington, Kansas  
(If additional description is necessary, use BACK of this sheet)

STATE OF KANSAS, COUNTY OF BARTON, ss.  
Glenn W. Peel (employee of owner) or (owner or operator) of the above-described well, being first duly sworn on oath, says: That I have knowledge of the facts, statements, and matters herein contained and the log of the above-described well as filed and that the same are true and correct. So help me God. GLENN W. PEEL

(Signature) BY: [Signature]  
P.O. Box 359, Hoisington, Kansas  
(Address)

SUBSCRIBED AND SWORN TO before me this 16th day of September, 1953

[Signature]  
Notary Public.

My commission expires June 4, 1955

24-7368-S 3-53-20M

PLUGGING  
FILE SEC 28 T 4 R 13a  
BOOK PAGE 129 LINE 28