


15-147-00099-00-00

STATE OF KANSAS  
STATE CORPORATION COMMISSION

Give All Information Completely  
Make Required Affidavit  
Mail or Deliver Report to:  
Conservation Division  
State Corporation Commission  
800 Bitting Building  
Wichita, Kansas

WELL PLUGGING RECORD

NORTH

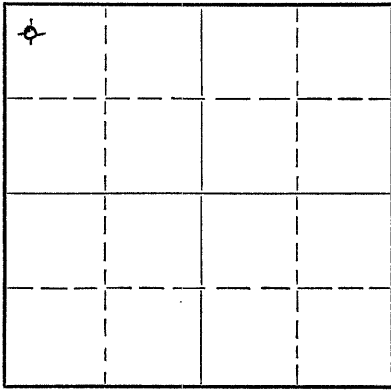

Locate well correctly on above  
Section Plat

Phillips County. Sec. 34 Twp. 4S Rge. 17W (W)  
Location as "NE/CNW $\frac{1}{4}$ SW $\frac{1}{4}$ " or footage from lines NW NW NW  
Lease Owner George P. Vye  
Lease Name C. A. Johnson Well No. 1  
Office Address 33 S. Clark Street, Chicago, Illinois  
Character of Well (completed as Oil, Gas or Dry Hole) Dry Hole  
Date well completed April 3 1953  
Application for plugging filed April 3 1953  
Application for plugging approved April 3 1953  
Plugging commenced April 3, 12:30 a.m. 1953  
Plugging completed April 3, 8:00 a.m. 1953  
Reason for abandonment of well or producing formation  
Commercial quantity of oil not found  
If a producing well is abandoned, date of last production 19  
Was permission obtained from the Conservation Division or its agents before plugging was commenced? Yes

Name of Conservation Agent who supervised plugging of this well Eldon Petty  
Producing formation Depth to top Bottom Total Depth of Well 3600 Feet  
Show depth and thickness of all water, oil and gas formations.

OIL, GAS OR WATER RECORDS

CASING RECORD

Formation	Content	From	To	Size	Put In	Pulled Out
				8 5/8"	146'	

Describe in detail the manner in which the well was plugged, indicating where the mud fluid was placed and the method or methods used in introducing it into the hole. If cement or other plugs were used, state the character of same and depth placed, from feet to feet for each plug set.

Set plug @ 144' and cemented w/45 sacks by Halliburton to plug hole

RECEIVED  
STATE CORPORATION COMMISSION  
APR 10 1953  
CONSULTING DIVISION  
Wichita, Kansas  
4-10-53

(If additional description is necessary, use BACK of this sheet)  
Name of Plugging Contractor Deek Drilling, Inc.  
Address 1006 Central Building, Wichita, Kansas

STATE OF Kansas, COUNTY OF Sedgwick, ss.  
Clinton Engstrand, agent for (employee of owner) or (owner or operator) of the above-described well,  
being first duly sworn on oath, says: That I have knowledge of the facts, statements, and matters herein contained and the log of the above-described well as filed and that the same are true and correct. So help me God.

(Signature) *Clinton Engstrand*  
(Address)

SUBSCRIBED AND SWORN to before me this 9 day of April 1953.

My commission expires October 29, 1955  
Notary Public.

PLUGGING  
FILE SEC 34 T 4 R 17 W  
BOOK PAGE 90 LINE 19