

15-147-20210-00-00

FORM CP-4


STATE OF KANSAS
STATE CORPORATION COMMISSION
CONSERVATION DIVISION
P. O. BOX 17027
WICHITA, KANSAS 67217

WELL PLUGGING RECORD

Phillips

County, Sec 19 Twp 14S Rge 17W (E)X (W)
NW NW SE

Location as "NE/CNW/SW" or footage from lines
Lease Owner Petroleum Management, Inc.
Lease Name McKinley Well No. 1
Office Address 400 N. Woodlawn, Suite 201, Wichita, Ks. 67208
Character of Well (completed as Oil, Gas or Dry Hole) dry hole
Date well completed 2-16-76 19
Application for plugging filed 2-15-76 19
Application for plugging approved 2-15-76 19
Plugging commenced 2-16-76 19
Plugging completed 2-16-76 19
Reason for abandonment of well or producing formation D&A

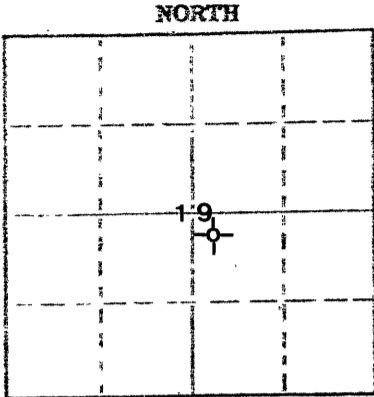

Locate well correctly on above Section Map

If a producing well is abandoned, date of last production 19
Was permission obtained from the Conservation Division or its agents before plugging was commenced? yes

Name of Conservation Agent who supervised plugging of this well Leo Massey
Producing formation _____ Depth to top _____ Bottom _____ Total Depth of Well 3160 Feet
Show depth and thickness of all water, oil and gas formations.

OIL, GAS OR WATER RECORDS

CASING RECORD

FORMATION	CONTENT	FROM	TO	SIZE	PUT IN	PULLED OUT
				8 5/8"	225.06'	-0-

Describe in detail the manner in which the well was plugged, indicating where the mud fluid was placed and the method or methods used in introducing it into the hole. If cement or other plugs were used, state the character of same and depth placed, from _____ feet to _____ feet for each plug set.

Plugged w/130 sx 50/50 Poz, 6% gel

RECEIVED
FEB 24 1976

(If additional description is necessary, use BACK of this sheet)

Name of Plugging Contractor Red Tiger Drilling Co. 2-24-76
Address 1720 KSB&T Bldg., Wichita, Kansas 67202

STATE OF Kansas COUNTY OF Sedgwick ss.
Jean Stocks (employee of owner) or (owner/operator) of the above-described well, being first duly sworn on oath, says: That I have knowledge of the facts, statements, and matters herein contained and the log of the above-described well as filed and that the same are true and correct. So help me God.

(Signature) Jean Stocks
1720 KSB&T Bldg., Wichita, Ks. 67202
(Address)

SUBSCRIBED AND SWORN TO before me this 20th day of February, 1976

My commission expires _____

(Signature) D'Ann Drennan
Notary Public

