

STATE OF KANSAS
 STATE CORPORATION COMMISSION
 200 Colorado Derby Bldg.
 Wichita, Kansas 67202

Form CP-4
 Rev. 12-15-80


15-147-20297-00-02

WELL PLUGGING RECORD

Give All Information Completely
 Make Required Affidavit

COUNTY Phillips SEC. 17 TWP. 4-S RGE. 18-W E/W
 Location as in quarters or footage from lines:

990' from west line, 990' from north line of the SE/4

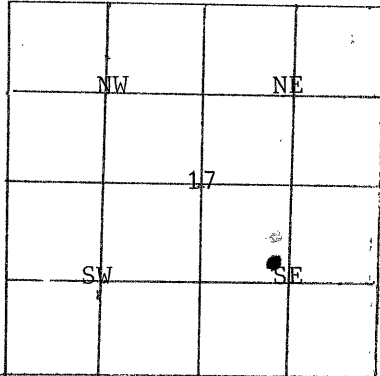

Locate Well
 correctly on above
 Section Platt.

Lease Owner Cherokee Petroleum Corp.

Lease Name Hanchett #2 Well No. 2

Office Address 410 17th, Suite 2300 Denver, CO 80202

Character of Well (Completed as Oil, Gas or Dry Hole): Oil

Date Well Completed July 2, 1981

Application for plugging filed May 12, 1982

Plugging commenced May 12, 1982

Plugging completed July 19, 1982

Reason for abandonment of well or producing formation _____

Well failed to produce hydrocarbon shows in paying quantities

Was permission obtained from the Conservation Division or it's

Agent's before plugging was commenced? Yes

Name of Conservation Agent who supervised plugging of this well Carl Goodrow

Producing formation LKC Depth to top 3156' bottom 3373' T.D. 3599'

Show depth and thickness of all water, oil and gas formations.

OIL, GAS OR WATER RECORDS

Casing Record

Formation	Content	From	To	Size	Put in	Pulled Out
LKC (A-H zone)	Oil/H2O	3174'	3373'	8 5/8	219'	none
Toronto	Oil/H2O	3156'	60'	5 1/2"	3466'	2116.92'

Describe in detail the manner in which the well was plugged, indicating where the mud fluid was placed and the method or methods used in introducing it into the hold. If cement or other plugs were used, state the character of same and depth placed, from _____ feet to _____ feet for each plug set.

Sanded casing form TD to 3150', ran plug/dumped 5 sks. cement 5/13/82. Ran 4 sks. hulls, 33 sks. gel. (4% gel 3% CC) 70 sks. cement (50/50 pos.), 7 sks. gel. (4% gel, 3%CC) 60 sks. cement (50/50 pos.) 8 5/8" plug, 10 sks. cement (50/50 pos.) (7-19-82)

(If additional description is necessary, use BACK of this sheet)

Name of Plugging Contractor Rocky Mountain Well Service Halliburton Co. Oil Field Service & Supply, Inc.

STATE OF KANSAS COUNTY OF DECATUR, ss.


James R. Betts, operator (employee of owner) or (owner or operator) of the above-described well, being first duly sworn on oath, says: That I have knowledge of the facts, statements, and matters herein contained and the log of the above-described well as filed and that the same are true and correct. So help me God.

(Signature) James R. Betts
 (Address) _____

SUBSCRIBED AND SWORN TO before me this 20th day of July, 19 82

My Commission expires: December 4, 1985

RECEIVED
 STATE CORPORATION COMMISSION
 Notary Public.

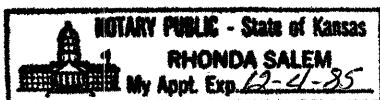

JUL 22 1982
 CONSERVATION DIVISION
 Wichita, Kansas

JUL 22 1982
 CONSERVATION DIVISION
 Wichita, Kansas
 7-22-82