


15-147-20091-00-01

STATE OF KANSAS
STATE CORPORATION COMMISSION
CONSERVATION DIVISION
P. O. BOX 17027
WICHITA, KANSAS 67217

FORM CP-4

WELL PLUGGING RECORD

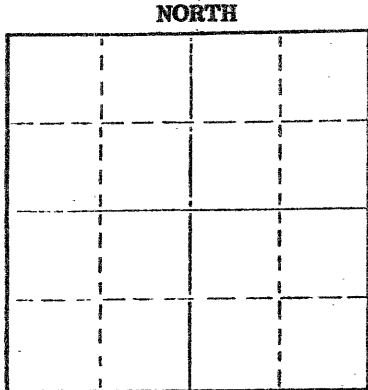

Locate well correctly on above Section Plat

Phillips County. Sec. 7 Twp. 4 Rge. 18 (E) (W) X
Location as "NE/CNWxSWx" or footage from lines C NW NW SW
Lease Owner Phillips Oil Operating Co.
Lease Name Meyer Well No. #2
Office Address Box 706 Enid, Oklahoma 73701
Character of Well (completed as Oil, Gas or Dry Hole)
Date well completed 19
Application for plugging filed 19
Application for plugging approved 19
Plugging commenced 7-10-75 19
Plugging completed 7-24-75 19
Reason for abandonment of well or producing formation
If a producing well is abandoned, date of last production 19
Was permission obtained from the Conservation Division or its agents before plugging was commenced?

Name of Conservation Agent who supervised plugging of this well Leo Massey
Producing formation Depth to top Bottom Total Depth of Well 3435'
Show depth and thickness of all water, oil and gas formations.

OIL, GAS OR WATER RECORDS

CASING RECORD

FORMATION	CONTENT	FROM	TO	SIZE	PUT IN	PULLED OUT
				4 1/2"	3434'	2277.77'
				8 5/8"	218.51'	

Describe in detail the manner in which the well was plugged, indicating where the mud fluid was placed and the method or methods used in introducing it into the hole. If cement or other plugs were used, state the character of same and depth placed, from feet to feet for each plug set.

Made bottom hole plug back with sand to 3000'. Mixed and ran 3 sacks cement thru dump bailer.
Plug bottom with 15 sacks gel - 3 sacks hulls - 70 sacks cement - 15 sacks gel plug 50 sacks cement.

(If additional description is necessary, use BACK of this sheet)
Name of Plugging Contractor Southwest Casing Pulling Co.
Address Box 364 Great Bend, Kansas

STATE OF Kansas COUNTY OF Barton ss.
Southwest Casing Pulling Co. (employee of owner) or (owner or operator) of the above-described well, being first duly sworn on oath, says: That I have knowledge of the facts, statements, and matters herein contained and the log of the above-described well as filed and that the same are true and correct. So help me God.

(Signature) W. C. Spencer Sec.
Box 364 Great Bend, Kansas
(Address)

Subscribed and Sworn to before me this 25 day of July, 1975
Sidney D. Ullrich
Notary Public.

My commission expires 24 October 1976

RECEIVED
STATE CORPORATION COMMISSION

JUL 28 1975
07-28-75
CONSERVATION DIVISION
Wichita, Kansas