

15-147-00037-00-00


STATE OF KANSAS
STATE CORPORATION COMMISSION

WELL PLUGGING RECORD

Give All Information Completely
Make Required Affidavit
Mail or Deliver Report to:
Conservation Division
State Corporation Commission
800 Bittling Building
Wichita, Kansas

OR
FORMATION PLUGGING RECORD Strike out upper line when reporting plugging of formations.

Phillips County. Sec. 32 Twp. 4 S Rge. (E) 18 (W)
Location as "NE 1/4 NW 1/4 SW 1/4" or footage from lines NE NE SE
Lease Owner Iron Drilling Company
Lease Name Fern Kay Ashcraft Well No. 1
Office Address 1206 Philtower Building Tulsa, Oklahoma
Character of Well (completed as Oil, Gas or Dry Hole) Dry Hole
Date well completed November 17, 1948 19
Application for plugging filed November 17, 1948 19
Application for plugging approved November 17, 1948 19
Plugging commenced November 17, 1948 19
Plugging completed November 17, 1948 19
Reason for abandonment of well or producing formation Dry Hole

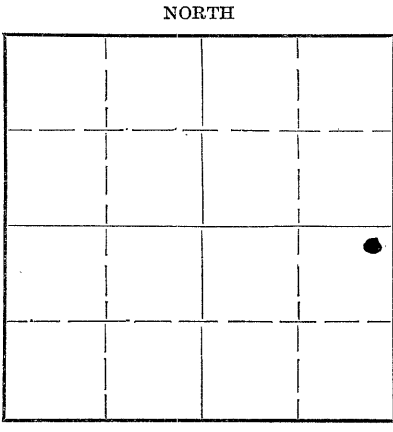

If a producing well is abandoned, date of last production 19
Was permission obtained from the Conservation Division or its agents before plugging was commenced? Yes

Name of Conservation Agent who supervised plugging of this well A. Reeves
Producing formation Depth to top Bottom Total Depth of Well 3471 Feet
Show depth and thickness of all water, oil and gas formations.

OIL, GAS OR WATER RECORDS CASING RECORD

Formation	Content	From	To	Size	Put In	Pulled Out

Describe in detail the manner in which the well was plugged, indicating where the mud fluid was placed and the method or methods used in introducing it into the hole. If cement or other plugs were used, state the character of same and depth placed, from feet to feet for each plug set.

Circulated heavy mud top to bottom
13-3/8" plug set at 120 ft with 20 sax cement
13-3/8" plug set at 30 ft. and hole filled to bottom of cellar with 20 sax cement

RECEIVED
CORPORATION DIV.
DEC - 1 1948
STATE CORPORATION
COMMISSION
KANSAS
12-1-48

(If additional description is necessary, use BACK of this sheet)
Correspondence regarding this well should be addressed to Iron Drilling Company
Address 1206 Philtower Building Tulsa, Oklahoma

STATE OF Oklahoma, COUNTY OF Tulsa, ss.
Herrick Babcock (employee of owner) or (owner or operator) of the above-described well,

being first duly sworn on oath, says: That I have knowledge of the facts, statements, and matters herein contained and the log of the above-described well as filed and that the same are true and correct. So help me God.

(Signature) Herrick Babcock
1206 Philtower Building Tulsa, Oklahoma
(Address)

SUBSCRIBED AND SWORN TO before me this 22nd day of November, 1948

My commission expires Feb. 28, 1952 Notary Public.

PLUGGING
FILE SEC 32 T 4 R 18W
BOOK PAGE 69 LINE 7