

STATE OF KANSAS  
STATE CORPORATION COMMISSION

WELL PLUGGING RECORD

Give All Information Completely  
Make Required Affidavit  
Mail or Deliver Report to  
Conservation Division  
State Corporation Comm.  
245 North Water  
Wichita, KS 67202

Phillips County. Sec 34 Twp. 4 Rge. 18 E/W  
Location as "NE/CNW $\frac{1}{4}$ /SW $\frac{1}{4}$ " or footage from lines  
NW SE SE

Lease Owner Kansas Oil Corp.  
Lease Name Ferguson Well No. 3  
Office Address 555 N. Woodlawn, Wichita, Ks.

Character of Well (Completed as Oil, Gas or Dry Hole)  
Oil


✓ Date Well completed 11-10-79 19  
Application for plugging filed 7-16 1980  
Application for plugging approved 7-18 1980  
Plugging commenced 7-22 1980  
Plugging completed 7-22 1980

Reason for abandonment of well or producing formation  
Non Commercial Value

If a producing well is abandoned, date of last production  
✓ Non Applicable 19

Was permission obtained from the Conservation Division or  
its agents before plugging was commenced? yes

Name of Conservation Agent who supervised plugging of this well Mr. Schmidt  
Producing formation "T" Depth to top 3142 Bottom 3146 Total Depth of Well 3453  
Show depth and thickness of all water, oil and gas formations.

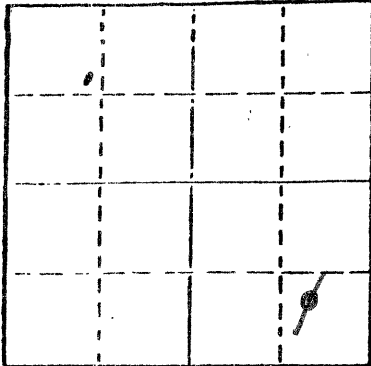

Locate well correctly on above  
Section Plot

OIL, GAS OR WATER RECORDS

CASING RECORD

FORMATION	CONTENT	FROM	TO	SIZE	PUT IN	PULLED OUT
Surface				8 5/8"	252	0'
Production				4 1/2"	3453	0'

Describe in detail the manner in which the well was plugged, indicating where the mud fluid was placed and the method or methods used in introducing it into the hold. If cement or other plugs were used, state the character of same and depth placed, from \_\_\_\_\_ feet to \_\_\_\_\_ feet for each plug set.

Plugged well w/ 45 sks cement - 3 sks. hulls - 35 sks. cement - 12 gal  
2 sks. hulls & 70 sks cement Pressured to 2000 lbs.

Allied cementing Pump truck

(If additional description is necessary, use BACK of this sheet)

Name of Plugging Contractor Midwest Casing Pulling, Box F, Sublette, Ks. Permit #766

STATE OF KANSAS COUNTY OF HASKELL, ss.  
I, Edgar J. Eves (employee of owner) or (owner or operator)  
of the above-described well, being first duly sworn on oath, says: That I have knowledge of  
the facts, statements, and matters herein contained and the log of the above-described well  
as filed and that the same are true and correct. So help me God.

(Signature)

*Edgar J. Eves*

Box F, Sublette, Ks. 67877  
(Address)

SUBSCRIBED AND SWORN TO before me this 17th day of August, 19 80

*Sondra L Eves*

Notary Public.

My commission expires 12-6-80



Rec'd  
8-18-80