

15-147-20235-00-00


STATE OF KANSAS  
STATE CORPORATION COMMISSION

WELL PLUGGING RECORD

Give All Information Completely  
Make Required Affidavit  
Mail or Deliver Report to  
Conservation Division  
State Corporation Comm.  
245 North Water  
Wichita, KS 67202

Phillips County, Sec. 34 Twp. 4 Rge. 18 E/W  
Location as "NE/CNW $\frac{1}{4}$ SW $\frac{1}{4}$ " or footage from lines  
NW NW SE

Lease Owner Kansas Oil Corp  
Lease Name Ferguson Well No. 2  
Office Address 555 N. Woodlawn, Wichita, Ks.  
Character of Well (Completed as Oil, Gas or Dry Hole)

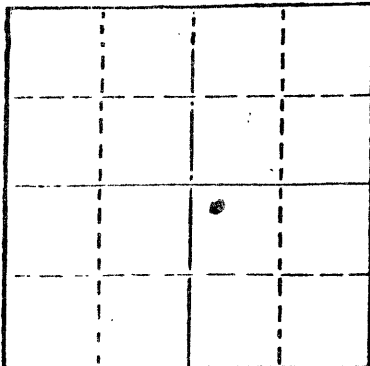

Locate well correctly on above  
Section Plat

Oil  
Date Well completed 9-11 1978  
Application for plugging filed 6-18 1980  
Application for plugging approved 6-20 1980  
Plugging commenced 7-10 1980  
Plugging completed 7-22 1980

Reason for abandonment of well or producing formation  
Lost Hole  
If a producing well is abandoned, date of last production  
11-20 1978

Was permission obtained from the Conservation Division or  
its agents before plugging was commenced? yes

Name of Conservation Agent who supervised plugging of this well Mr. Schmidt  
Producing formation "G" zone Depth to top 3098 Bottom 3194 Total Depth of Well 3285'  
Show depth and thickness of all water, oil and gas formations.

OIL, GAS OR WATER RECORDS

CASING RECORD

FORMATION	CONTENT	FROM	TO	SIZE	PUT IN	PULLED OUT
Surface				8 5/8"	252'	0'
Production				4 1/2"	3284'	1310'

Describe in detail the manner in which the well was plugged, indicating where the mud fluid was placed and the method or methods used in introducing it into the hold. If cement or other plugs were used, state the character of same and depth placed, from \_\_\_\_\_ feet to \_\_\_\_\_ feet for each plug set.

Pumped 1 sk. hulls & 10 sks. cement to 2950' - pressured to 750 lbs.  
Plugged top w/ 3 sks. hulls - 12 sks. gel - 70 sks cement - 4 sks gel  
2 sks. hulls & 70 sks. cement

Allied cementing pump truck

RECEIVED  
STATE CORPORATION COMMISSION

SEP 23 1980  
CONSERVATION DIVISION  
Wichita, Kansas

(If additional description is necessary, use BACK of this sheet)  
Name of Plugging Contractor Midwest Casing Pulling, Box F, Sublette, Ks. Permit #766

STATE OF KANSAS COUNTY OF HASKELL  
I, Edgar J. Eves (employee of owner) or (owner or operator)

of the above-described well, being first duly sworn on oath, says: That I have knowledge of the facts, statements, and matters herein contained and the log of the above-described well as filed and that the same are true and correct. So help me God.

(Signature) Edgar J. Eves  
Box F., Sublette, Ks. 67877  
(Address)

SUBSCRIBED AND SWORN TO before me this 17th day of August, 19 80

Sandra L. Eves  
Notary Public.

My commission expires 12-6-80

