

15-147-30127-00-00

STATE OF KANSAS
STATE CORPORATION COMMISSION


Form CP-4

WELL PLUGGING RECORD

Give All Information Completely
Make Required Affidavit
Mail or Deliver Report to:
Conservation Division
State Corporation Commission
212 No. Market
Wichita, Kansas

Phillips County, Sec. 30 Twp. 4S Rge. 18W (E) (W)

Location as "NE/CNW/SE/SW" or footage from lines NE SW NE
Lease Owner Petroleum Management, Inc.
Lease Name Parker Well No. 2
Office Address 1515 Wichita Plaza, Wichita, Kansas
Character of Well (completed as Oil, Gas or Dry Hole) Dry Hole
Date well completed February 13, 1966
Application for plugging filed February 13, 1966
Application for plugging approved February 13, 1966
Plugging commenced February 13, 1966
Plugging completed February 13, 1966
Reason for abandonment of well or producing formation D & A

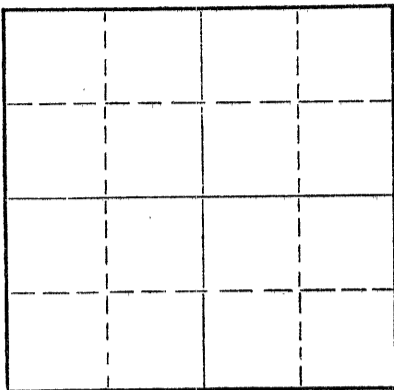

Locate well correctly on above
Section Plat

If a producing well is abandoned, date of last production 19

Was permission obtained from the Conservation Division or its agents before plugging was commenced? Yes

Name of Conservation Agent who supervised plugging of this well Gilbert Leiker

Producing formation _____ Depth to top _____ Bottom _____ Total Depth of Well 2420 Feet

Show depth and thickness of all water, oil and gas formations.

OIL, GAS OR WATER RECORDS

CASING RECORD

FORMATION	CONTENT	FROM	TO	SIZE	PUT IN	PULLED OUT
				8 5/8"	190'	None

Describe in detail the manner in which the well was plugged, indicating where the mud fluid was placed and the method or methods used in introducing it into the hole. If cement or other plugs were used, state the character of same and depth placed, from _____ feet to _____ feet for each plug set.

Set plug at 540', 20 sacks of cement,
plug at 190', 20 sacks of cement,
plug at 40', 1/2 sack of hulls, 10
sacks of cement.

RECEIVED
STATE CORPORATION COMMISSION

FEB 17 1966

2-17-66

CONSERVATION DIVISION
WICHITA, KANSAS

(If additional description is necessary, use BACK of this sheet)

Name of Plugging Contractor Red Tiger Drilling Company
Address Box 173 -- Russell, Kansas

STATE OF KANSAS, COUNTY OF SEDGWICK, ss.
Maxine V. Starr (employee of owner) or (~~owner or operator~~) of the above-described well, being first duly sworn on oath, says: That I have knowledge of the facts, statements, and matters herein contained and the log of the above-described well as filed and that the same are true and correct. So help me God.

(Signature) Maxine V. Starr
1720 Wichita Plaza, Wichita, Kansas
(Address)

SUBSCRIBED AND SWORN TO before me this 15th day of February, 19 66

Jean Holler

My commission expires 5-22-66

Notary Public.