

13-147-30088-00-00


STATE OF KANSAS  
STATE CORPORATION COMMISSION

Form CP-4

WELL PLUGGING RECORD

Give All Information Completely  
Make Required Affidavit  
Mail or Deliver Report to:  
Conservation Division  
State Corporation Commission  
212 No. Market  
Wichita, Kansas 67202

Phillips County, Sec. 21 Twp. 4 Rge. 18 (#) (W)  
Location as "NE/CNW/SW" or footage from lines NW NW SW  
Lease Owner PMI  
Lease Name Barney Morgan Well No. 1  
Office Address 400 N. Woodlawn Wichita Kansas  
Character of Well (completed as Oil, Gas or Dry Hole) Oil-converted to injection  
Date well completed July 23 1965  
Application for plugging filed Dec. 13 1977  
Application for plugging approved Dec. 16 1977  
Plugging commenced March 16 1978  
Plugging completed March 16 1978  
Reason for abandonment of well or producing formation \_\_\_\_\_

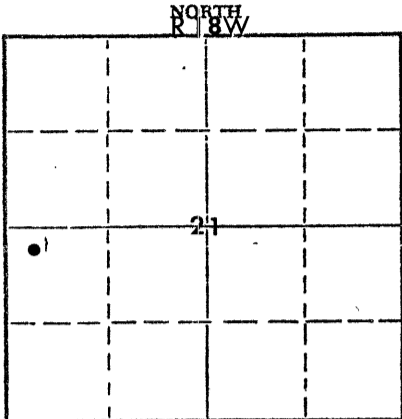

Locate well correctly on above  
Section Plat

If a producing well is abandoned, date of last production \_\_\_\_\_ 19\_\_\_\_  
Was permission obtained from the Conservation Division or its agents before plugging was commenced? yes

Name of Conservation Agent who supervised plugging of this well Leo Massey  
Producing formation KC Depth to top 3113 Bottom 3342 Total Depth of Well 3508 Feet  
Show depth and thickness of all water, oil and gas formations.

OIL, GAS OR WATER RECORDS

CASING RECORD

FORMATION	CONTENT	FROM	TO	SIZE	PUT IN	PULLED OUT
				8 5/8	193'	0
				4 1/2	3413	749'

Describe in detail the manner in which the well was plugged, indicating where the mud fluid was placed and the method or methods used in introducing it into the hole. If cement or other plugs were used, state the character of same and depth placed, from \_\_\_\_\_ feet to \_\_\_\_\_ feet for each plug set.

Plug back w sand to 3100' Dumped 3 excrement w bailer  
Pumped 25 sacks gel 1 sack hulls and plug followed by 140 sacks 60-40  
pozmix down 8 5/8 pipe  
Cement from 420' to surface

RECEIVED  
STATE CORPORATION COMMISSION  
APR 04 1978  
4-4-78  
CONSERVATION DIVISION  
Wichita, Kansas

(If additional description is necessary, use BACK of this sheet)

Name of Plugging Contractor Petroleum Management Inc.  
Address 400 N. Woodlawn Wichita Kansas

STATE OF KANSAS, COUNTY OF SEDGWICK, ss.  
Dale Silcott (employee of owner) or (owner or operator) of the above-described well, being first duly sworn on oath, says: That I have knowledge of the facts, statements, and matters herein contained and the log of the above-described well as filed and that the same are true and correct. So help me God.

(Signature) Dale Silcott  
400 N. Woodlawn, Suite 201, Wichita, Ks. 67208  
(Address)

SUBSCRIBED AND SWORN TO before me this 30th day of March, 19 78

Bonnie Brown  
Bonnie Brown  
Notary Public.

M  
3/1/81  
BONNIE BROWN  
Sedgwick County, Ks.  
My Appt. Exp. 3-1-81