

15-147-00162-00-00


STATE OF KANSAS
STATE CORPORATION COMMISSION

Form CP-4

Give All Information Completely
Make Required Affidavit
Mail or Deliver Report to:
Conservation Division
State Corporation Commission
211 No. Broadway
Wichita, Kansas

WELL PLUGGING RECORD

NORTH

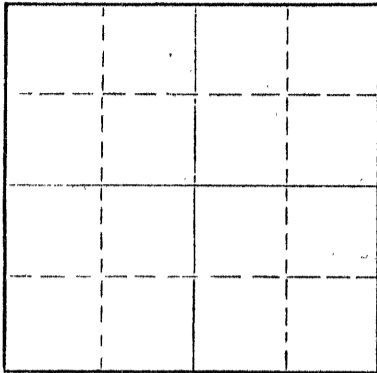

Locate well correctly on above
Section Plat

Phillips County. Sec. 23 Twp. 4S Rge. 20 (E) (W)
Location as "NE/CNWxSWx" or footage from lines C NW NE SE
Lease Owner Burch Exploration, Ltd.
Lease Name Siegrist Well No. 1
Office Address 1011 Union Center, Wichita, Kansas
Character of Well (completed as Oil, Gas or Dry Hole) Dry Hole
Date well completed 9-15-64 19
Application for plugging filed 9-15-64 19
Application for plugging approved 9-15-64 19
Plugging commenced 9-15-64 19
Plugging completed 9-15-64 19
Reason for abandonment of well or producing formation Dry hole

If a producing well is abandoned, date of last production 19
Was permission obtained from the Conservation Division or its agents before plugging was commenced? yes

Name of Conservation Agent who supervised plugging of this well Eldon Petty
Producing formation _____ Depth to top _____ Bottom _____ Total Depth of Well 3615 Feet
Show depth and thickness of all water, oil and gas formations.

OIL, GAS OR WATER RECORDS

CASING RECORD

FORMATION	CONTENT	FROM	TO	SIZE	PUT IN	PULLED OUT
				8-5/8	215'	none

Describe in detail the manner in which the well was plugged, indicating where the mud fluid was placed and the method or methods used in introducing it into the hole. If cement or other plugs were used, state the character of same and depth placed, from _____ feet to _____ feet for each plug set.

First plug set @ 540' with 20 sacks
Second plug set @ 200' with 20 sacks
Third plug set @ 40' with 10 sacks

RECEIVED
STATE CORPORATION COMMISSION

SEP 25 1964

9-25-64

CONSERVATION DIVISION
Wichita, Kansas

Name of Plugging Contractor Burch Exploration, Ltd.
Address 1011 Union Center, Wichita, Kansas

STATE OF KANSAS, COUNTY OF SEDGWICK, ss. Earl M. Burch, General Partner
well, being first duly sworn on oath, says: That I have knowledge of the facts, statements, and matters herein contained and the log of the above-described well as filed and that the same are true and correct. So help me God

(Signature) Earl M. Burch
1011 Union Center, Wichita, Kansas
(Address)

SUBSCRIBED AND SWORN to before me this 15th day of September, 19 64

My commission expires June 18, 1969 Munnie E. Matson Notary Public.

15-147-00162-00-00

WELL LOG

Burch Exploration, Ltd. #1 Stegrist
C NW NE SE Sec. 23-48-20W
Phillips County, Kansas

Set 8-5/8" @ 215' with 160 sacks plus MAS.
Elevation: 2995 KB
Commenced: 9-9-64
Completed: 9-15-64

D & A

Logs

1632 Sand & Shale
1639 Anhydrite
1970 Shale
3615 Lime and Shale
3615 Rotary Total Depth

Anhydrite 1622 (-471)
Heebner 3210 (-1117)
Toronto 3230 (-1145)
Lansing 3253 (-1168)
Base Kansas City 3450 (-1365)
Conglomerate 3490 (-1403)
Arbuckle 3660 (-1473)

DST #1. 3275-3325. Open 1-1/2 hours
shut in 30 mins. Recovered 1100' oil
cut muddy saltwater. IBHP 11200; IFP 2720;
FFP 5960; FBHP 10300.

DST #2. 3300-3325. Open 1 hour shut
in 30 mins. Recovered 320' slightly oil
cut muddy saltwater. IBHP 10930; IFP 2560;
FFP 7700; FBHP 10320.

DST #3. 3325-3350. Open 1 hour shut in
30 mins. Recovered 50' slightly oil cut
mud. IBHP 11620; IFP 340; FFP 610;
FBHP 10940.

DST #4. 3350-3350. Open 1 hour shut in
30 mins. Recovered 5' mud. IBHP 300;
IFP 340; FFP 340; FBHP 700.

DST #5. 3390-3440. Open 1 hour.
Recovered 5' mud. IBHP 2900; IFP 510;
FFP 510; FBHP 1114.

RECEIVED
STATE CORPORATION COMMISSION

SEP 25 1964
92564
CONSERVATION DIVISION
Wichita, Kansas

STATE OF KANSAS)
) SS:
COUNTY OF SEDGWICK)

92564

I, Earl M. Burch, General Partner of Burch Exploration, Ltd., being duly sworn
on oath, state: That I have knowledge of the facts, statements and matters herein
contained and that the same are true and correct.

Earl M. Burch
Earl M. Burch, General Partner

Subscribed and sworn to before me this 24th day of September, 1964.

Minnie E. Matson
Minnie E. Matson, Notary Public

My commission expires June 18, 1968