

15-147-20345-00-00

WELL PLUGGING RECORD

Give All Information Completely  
Make Required Affidavit

COUNTY Phillips SEC. 20 TWP. 4S RGE. 20W E/W  
Location as in quarters or footage from lines:  
SE SE NW


Lease Owner F & M Oil Co., Inc.  
Lease Name States Well No. 1  
Office Address 422 Union Center, Wichita, Ks. 67202  
Character of Well (Completed as Oil, Gas or Dry Hole): \_\_\_\_\_  
Date Well Completed 8/16/81  
Application for plugging filed 8/16/81  
Plugging commenced 8/16/81  
Plugging completed 8/16/81  
Reason for abandonment of well or producing formation \_\_\_\_\_

Locate Well  
correctly on above  
Section Platt.

Dry Hole  
Was permission obtained from the Conservation Division or it's  
Agent's before plugging was commenced? yes

Name of Conservation Agent who supervised plugging of this well Marion Schmidt  
Producing formation \_\_\_\_\_ Depth to top \_\_\_\_\_ bottom \_\_\_\_\_ T.D. 3580

Show depth and thickness of all water, oil and gas formations.

OIL, GAS OR WATER RECORDS

Casing Record

Formation	Content	From	To	Size	Put in	Pulled Out
	Surface	0	327	8 5/8"	327	None

Describe in detail the manner in which the well was plugged, indicating where the mud  
fluid was placed and the method or methods used in introducing it into the hold. If cement  
or other plugs were used, state the character of same and depth placed, from \_\_\_\_\_ feet  
to \_\_\_\_\_ feet for each plug set.

1st plug @ 930' w/70 sx  
2nd plug @ 300' w/40 sx  
3rd plug @ 40' w/10 sx  
5 sx in rathole

(If additional description is necessary, use BACK of this sheet)  
Name of Plugging Contractor Thunderbird Drilling, Inc.

RECEIVED  
STATE CORPORATION COMMISSION  
SEP - 4 1981  
CONSERVATION DIVISION  
Wichita, Kansas  
9-4-81


STATE OF KANSAS COUNTY OF SEDGWICK, ss.  
Burke Krueger (employee of owner) or (owner or operator) of the  
above-described well, being first duly sworn on oath, says: That I have knowledge of the  
facts, statements, and matters herein contained and the log of the above-described well as  
filed and that the same are true and correct. So help me God.

(Signature) [Signature]  
P.O. Box 18407- Wichita, Ks. 67218  
(Address)

SUBSCRIBED AND SWORN TO before me this 3rd day of September, 19 81

Gloria DeJesus  
Gloria DeJesus Notary Public.

My Commission expires: 3-25-84

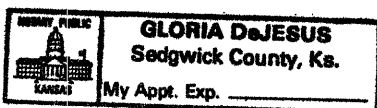

KANSAS


WELL COMPLETION REPORT AND DRILLER'S LOG

S. 20 T. 4S R. 20W E W

Loc. SE SE NW

County Phillips

640 Acres N

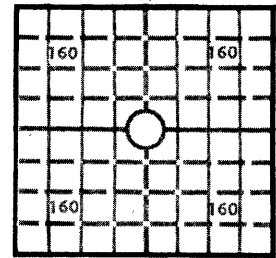

Locate well correctly

Elev.: Gr. 2071

DF \_\_\_\_\_ KB \_\_\_\_\_

API No. 15 — 147 — 20,345-00-00  
County Number

Operator  
F & M OIL CO., Inc.

Address  
422 Union Center Wichita, Kansas 67202

Well No. #1 Lease Name States

Footage Location  
feet from (N) (S) line feet from (E) (W) line

Principal Contractor Geologist  
Thunderbird Drilling Paul Montoia

Spud Date Date Completed Total Depth P.B.T.D.  
08-09-81 08-16-81 3583

Directional Deviation Oil and/or Gas Purchaser

CASING RECORD

Report of all strings set — surface, intermediate, production, etc.

Purpose of string	Size hole drilled	Size casing set (in O.D.)	Weight lbs/ft.	Setting depth	Type cement	Sacks	Type and percent additives
Surface	12 1/4	8 5/8		327'	common	250	2% gel 3% Ca. Cl

LINER RECORD

PERFORATION RECORD

Top, ft.	Bottom, ft.	Sacks cement	Shots per ft.	Size & type	Depth interval

TUBING RECORD

Size	Setting depth	Packer set at

ACID, FRACTURE, SHOT, CEMENT SQUEEZE RECORD

Amount and kind of material used	Depth interval treated

INITIAL PRODUCTION

Date of first production		Producing method (flowing, pumping, gas lift, etc.)			
RATE OF PRODUCTION PER 24 HOURS	Oil	Gas	Water	Gas-oil ratio	
	bbls.	MCF	bbls.	CFPB	
Disposition of gas (vented, used on lease or sold)			Producing interval (s)		

INSTRUCTIONS: As provided in KCC Rule 82-2-125, within 90 days after completion of a well, one completed copy of this Drillers Log shall be transmitted to the State Geological Survey of Kansas, 4150 Monroe Street, Wichita, Kansas 67209. Copies of this form are available from the Conservation Division, State Corporation Commission, 245 No. Water, Wichita, Kansas 67202. Phone AC 316-522-2206. If confidential custody is desired, please note Rule 82-2-125. Drillers Logs will be on open file in the Oil and Gas Division, State Geological Survey of Kansas, Lawrence, Kansas 66044.

Operator  
F & M OIL CO., Inc.

DESIGNATE TYPE OF COMP.: OIL, GAS,  
DRY HOLE, SWDW, ETC.:  
Dry

Well No. #1 Lease Name States

S 20 T 4S R 20W E W

**WELL LOG**

Show all important zones of porosity and contents thereof; cored intervals, and all drill-stem tests, including depth interval tested, cushion used, time tool open, flowing and shut-in pressures, and recoveries.

SHOW GEOLOGICAL MARKERS, LOGS RUN, OR OTHER DESCRIPTIVE INFORMATION.

FORMATION DESCRIPTION, CONTENTS, ETC.	TOP	BOTTOM	NAME	DEPTH
DST#1 3279-3345', 30-60-30-60-, recovered 60' very slight oil cut mud 60' slight ocm, 360' msw, ifp 92-185#, isip 1030#, ffp 216-278#, fsip 1020#.			Sample Tops:	
			Anhydrite	1656 (+ 830)
			B/Anhydrite	1686 (+385)
			Topeka	3057 (- 986)
			Heebner	3251 (-1180)
			Lansing	3294 (-1223)
			Electric LOG TOPS	
DST#2 3372-3411, 30-60-30-60, Weak to fair Blow. recovered 180' salt water. fp 51-123#, sip 1030-959.			Topeka	3061 (- 990)
			Heebner	3252 (-1181)
			Toronto	3280 (-1209)
			Lansing	3296 (-1225)
			B/KC	3492 (-1421)
			Arbuckle	3567 (-1496)
			LTD	3583 (-1512)

RECEIVED  
STATE CORPORATION COMMISSION  
SEP 17 1981  
CONSERVATION DIVISION  
Wichita, Kansas

USE ADDITIONAL SHEETS, IF NECESSARY, TO COMPLETE WELL RECORD.

Date Received

*E.A. Falkowski*

Signature

President

Title

September 16, 1981

Date

