

Give All Information Completely
Make Required Affidavit
Mail or Deliver Report to:
Conservation Division
State Corporation Commission
800 Bittling Building
Wichita, Kansas

WELL PLUGGING RECORD

15-147-00134-00-00

NORTH

Locate well correctly on above
Section Plat

Phillips County. Sec. 19 Twp. 4S Rge. 20 (W) X
Location as "NE/CNW/SW" or footage from lines SW NW NW
Lease Owner Fred B. Anschutz
Lease Name Noel Well No. 1
Office Address 1411 Mile High Center, Denver, Colorado
Character of Well (completed as Oil, Gas or Dry Hole) Dry Hole
Date well completed November 30, 19 55
Application for plugging filed November 30, 19 55
Application for plugging approved November 30, 19 55
Plugging commenced November 30, 19 55
Plugging completed November 30, 19 55
Reason for abandonment of well or producing formation Dry hole

If a producing well is abandoned, date of last production 19
Was permission obtained from the Conservation Division or its agents before plugging was commenced? yes

Name of Conservation Agent who supervised plugging of this well Mr. Eldon Petty, Box 326, Hays, Kansas
Producing formation Depth to top Bottom Total Depth of Well Feet
Show depth and thickness of all water, oil and gas formations.

OIL, GAS OR WATER RECORDS

CASING RECORD

FORMATION	CONTENT	FROM	TO	SIZE	PUT IN	PULLED OUT
				8 5/8	234	None

Describe in detail the manner in which the well was plugged, indicating where the mud fluid was placed and the method or methods used in introducing it into the hole. If cement or other plugs were used, state the character of same and depth placed, from feet to feet for each plug set.

Bottom Plug set at 210' with 15 sacks cement
Top Plug set at 40' with 10 sacks cement.
Completed 8 a.m. 11-30-55

(If additional description is necessary, use BACK of this sheet)

Name of Plugging Contractor Anschutz Drilling Co., Inc.
Address 1411 Mile High Center, Denver, Colorado


STATE OF Colorado, COUNTY OF Denver, ss.
E. G. Koelling (employee of owner) or (owner or operator) of the above-described well, being first duly sworn on oath, says: That I have knowledge of the facts, statements, and matters herein contained and the log of the above-described well as filed and that the same are true and correct. So help me God.

(Signature) E. G. Koelling
1411 Mile High Center, Denver, Colorado
(Address)

SUBSCRIBED AND SWORN TO before me this 13th day of December, 1955

My commission expires October 4, 1959

Yvonne M. Robertson
Yvonne M. Robertson Notary Public.

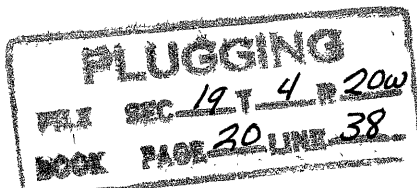

DEC 16 1955 12-16-55

CONSERVATION DIVISION
WICHITA, KANSAS

15-147-00134-00-00

DRILLER'S LOG

Fred E. Anschutz
No. 1 Noel
SW NW NW 19-4S-20W
Phillips County
Kansas

COMMENCED: November 21, 1955

COMPLETED: November 30, 1955

<u>FROM</u>	<u>TO</u>	
0	60	Soil & Sand
60	215	Shale & Shells
215	460	Shale
460	1280	Shale w/sand streaks
1280	1460	Sand
1460	1728	Red bed & Shale
1728	2155	Shale & Shells
2155	2295	Shale & Lime
2295	2605	Lime & Shale
2605	2675	Lime
2675	2860	Shaled Lime
2860	3687	Lime & Shale
	3687	TOTAL ROTARY DEPTH

CASING REPORT:

Set 234' 8 5/8" casing
with 275 sacks cement 2 cc

STATE OF COLORADO)
COUNTY OF DENVER) SS

I hereby affirm that the above and foregoing is a true and correct copy of
the log of the No. 1 Noel, SW NW NW Section 19-4S-20W, Phillips County, Kansas.

ANSCHUTZ DRILLING CO., INC.

By: *E. G. Koelling*
E. G. Koelling

Subscribed and sworn to before me this 13th day of December, 1955.

Yvonne M. Robertson
Yvonne M. Robertson
Notary Public

My Commission Expires: October 4, 1959

12-16-55

PLUGGING
FILE NO. 19-4-20W
BOOK PAGE 30 LINE 38