

15-147-20418-00-00

STATE OF KANSAS
STATE CORPORATION COMMISSION

FORM CP-4

WELL PLUGGING RECORD

Give All Information Completely
Make Required Affidavit
Mail or Deliver Report to
Conservation Division
State Corporation Comm.
200 Colorado Derby Bldg.
202 W. 1st St.
Wichita, KS 67202

Phillips County Sec. 1 Twp. 4 Rge. 20W
Location as "NE/CNW/SW" or footage from lines _____
C N/2 NE/4 NW/4

Lease Owner American Petroleum Co., Inc.
Lease Name _____ Well No. #1
Office Address 400 N. Woodlawn, Suite 111 Wichita, Ks 67208

Character of Well (Completed as Oil, Gas or Dry Hole) _____
Dry Hole


Date Well completed 7-30 19 83
Application for plugging filed 7-30 19 83
Application for plugging approved 7-30 19 83
Plugging commenced 5:15 P.M. 7-30 19 83
Plugging completed 6:30 P.M. 7-30 19 83

Reason for abandonment of well or producing formation _____
No Commercial Production

If a producing well is abandoned, date of last production _____ 19 _____

Was permission obtained from the Conservation Division or its agents before plugging was commenced? Yes

Name of Conservation Agent who supervised plugging of this well Marion Schmidt
Producing formation _____ Depth to top _____ Bottom _____ Tl. Depth of Well _____
Show depth and thickness of all water, oil and gas formations.

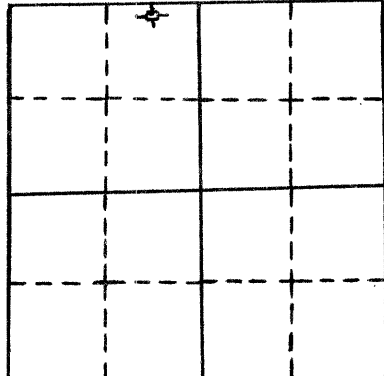

locate well correctly
on above
Section Plot

OIL, GAS OR WATER RECORDS.

CASING RECORD

FORMATION	CONTENT	FROM	TO	SIZE	PUT IN	PULLED OUT
Surface Casing	common	0'	207'	8 5/8"	207'	0'

Describe in detail the manner in which the well was plugged, indicating where the mud fluid was placed and the method or methods used in introducing it into the hold. If cement or other plugs were used, state the character of same and depth placed, from _____ feet to _____ feet for each plug set.


Plug #1 1650' with 20sxs
Plug #2 1000' with 100sxs
Plug #3 250' with 40sxs
Plug #4 40' with 10sxs
10sxs in rathole
Total--180sxs 50-50pos
6%ael 3%cc
P.D. @ 6:30 P.M. 7-30-83

(If additional description is necessary, use BACK of this sheet)

Name of Plugging Contractor Pioneer Drilling Company
308 West Mill Plainville, Ks 67663

STATE OF KANSAS COUNTY OF SEDGWICK, ss.

JAMES T. BARVAIS (employee of owner) or ~~XXXXXX~~ of the above described well, being first duly sworn on oath, says: That I have knowledge of the facts, statements, and matters herein contained and the log of the above described well is filed and that the same are true and correct. So help me God.

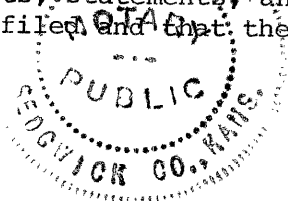

Rec'd
8-8-83

(Signature) James T. Barvais
(Address) JAMES T. BARVAIS
400 N. WOODLAWN, SUITE 111
WICHITA, KS. 67208

SUBSCRIBED AND SWORN TO before me this 6TH. day of AUGUST, 19 83

My commission expires 1-22-85

Jeggy Bennett
Notary Public