

WELL PLUGGING RECORD

Give All Information Completely
Make Required Affidavit
Mail or Deliver Report to
Conservation Division
State Corporation Comm.
200 Colorado Derby Bldg.
202 W. 1st. St.
Wichita, KS 67202

Phillips County Sec. 1 Twp. 4s Rge. 20 E/W
Location as "NE/CNW/SW" or footage from lines

363000 FSL 904' FEL KCC ayB

Lease Owner American Petroleum Company

Lease Name Merklein Well No. 1-A

Office Address 400 North Woodlawn, Suite 111 Wichita, Ks.

Character of Well (Completed as Oil, Gas or Dry Hole)
Dry Hole

Date Well completed 5-2 19 83

Application for plugging filed 5-2 19 83

Application for plugging approved 5-2 19 83

Plugging commenced 7:00PM 5-2 19 83


Plugging completed 8:45PM 5-2 19 83

Reason for abandonment of well or producing formation
No Commercial Production

If a producing well is abandoned, date of last production
NOT APPLICABLE 19

Was permission obtained from the Conservation Division or
its agents before plugging was commenced? Yes
Marion Schmidt

Name of Conservation Agent who supervised plugging of this well
Producing formation Depth to top Bottom Tl. Depth of Well
Show depth and thickness of all water, oil and gas formations.

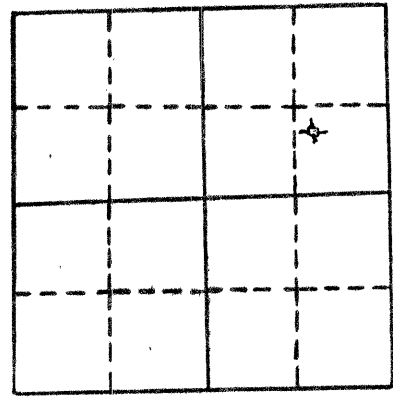

locate well correctly
on above
Section Plot

OIL, GAS OR WATER RECORDS

CASING RECORD

FORMATION	CONTENT	FROM	TO	SIZE	PUT IN	PULLED OUT
surface casing	60-40 pos	0'	212'	8 5/8"	212'	0'

Describe in detail the manner in which the well was plugged, indicating where the mud fluid was placed and the method or methods used in introducing it into the hold. If cement or other plugs were used, state the character of same and depth placed, from _____ feet to _____ feet for each plug set.


- Plug #1 at 1700' with 20 sxs
- Plug #2 at 1030' with 100 sxs
- Plug #3 at 220' with 40 sxs
- Plug #4 at 40' with 10 sxs- 1 sk. hulls & plug for solid bridge
10 sxs in rathole
- TOTAL -----180 sxs 50-50 pos 6%gel 2%cc
- P.D. 8:45 PM 5-2-83

(If additional description is necessary, use BACK of this sheet)

Name of Plugging Contractor Pioneer Drilling Co.
308 W. MILL Plainville, KS. 67663

STATE OF KANSAS COUNTY OF SEDGWICK, ss.

JAMES T. BARVAIS (owner or operator) of the above described well, being first duly sworn on oath, says: That I have knowledge of the facts, statements, and matters herein contained and the log of the above described well is filed and that the same are true and correct. So help me God.

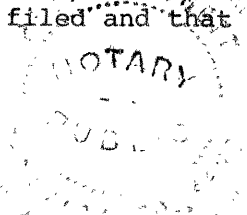

MAY 18 1983

CONSERVATION DIVISION
Wichita, Kansas

(Signature) James T. Barvais
JAMES T. BARVAIS, President
(Address) 400 NORTH WOODLAWN
SUITE 111
WICHITA, KS. 67208

SUBSCRIBED AND SWORN TO before me this 6th. day of MAY, 19 83

My commission expires 1-22-85

REGGY BENNETT
Notary Public