


15-147-~~00109~~-00-00
00109-

WELL PLUGGING RECORD

Give All Information Completely
Make Required Affidavit
Mail or Deliver Report to:
Conservation Division
State Corporation Commission
800 Biting Building
Wichita, Kansas

Phillips County. Sec. 13 Twp. 4S Rge. 19W (E) (W)

Location as "NE/CNW/SW" or footage from lines NE/4 NE/4 SW/4
Lease Owner Anderson-Prichard Oil Corp.
Lease Name Becker
Office Address Liberty Bank Building, Oklahoma City, Oklahoma
Character of Well (completed as Oil, Gas or Dry Hole) Dry Hole
Date well completed Sept. 5 1952
Application for plugging filed Sept. 5 1952
Application for plugging approved Sept. 5 1952
Plugging commenced Sept. 5 1952
Plugging completed Sept. 5 1952
Reason for abandonment of well or producing formation Dry Hole

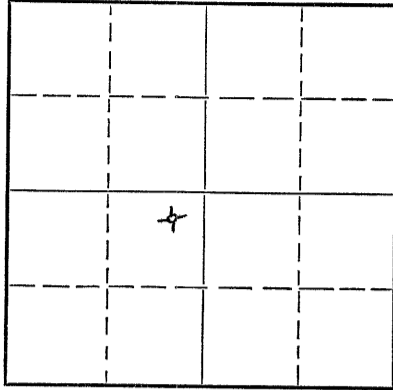

Locate well correctly on above Section Plat

If a producing well is abandoned, date of last production 19...
Was permission obtained from the Conservation Division or its agents before plugging was commenced? Yes

Name of Conservation Agent who supervised plugging of this well E. R. Petty
Producing formation Depth to top Bottom Total Depth of Well Feet
Show depth and thickness of all water, oil and gas formations.

OIL, GAS OR WATER RECORDS

CASING RECORD

Formation	Content	From	To	Size	Put In	Pulled Out
		0	210'	8 5/8"	210'	None

Describe in detail the manner in which the well was plugged, indicating where the mud fluid was placed and the method or methods used in introducing it into the hole. If cement or other plugs were used, state the character of same and depth placed, from feet to feet for each plug set.

3572' - 201 1/2' - Heavy Rotary Mud
201 1/2' - 200' - Wooden Plug
200' - 154' - 15 sacks cement
154' - 41 1/2' - Heavy Rotary Mud
41 1/2' - 40' - 10 Wooden Plug
40' - 6' - 10 sacks cement
6' - Surface - Cellar

RECEIVED
STATE CORPORATION COMMISSION

SEP 11 1952

Name of Plugging Contractor Glenn W. Peel
Address P. O. Box 359, Hoisington, Kansas
Wichita, Kansas

STATE OF Kansas COUNTY OF Barton, ss.
Glenn W. Peel (employee of owner) or (owner or operator) of the above-described well,

being first duly sworn on oath, says: That I have knowledge of the facts, statements, and matters herein contained and the log of the above-described well as filed and that the same are true and correct. So help me God.

(Signature) BY: Glenn W. Peel
P. O. Box 359
Hoisington, Kansas (Address)

SUBSCRIBED AND SWORN to before me this 9th day of September, 1952

My commission expires June 41, 1955
Notary Public.

PLUGGING
FILE SEC 13 T 4 R 19W
BOOK PAGE 43 LINE 8

15-147-00109-06-00

DRILLER'S LOG

Company: Anderson-Prichard Oil Corp.

NE/4 NE/4 SW/4
Sec. 13, Twp. 4S, Rge. 19W

Farm: Becker Well No. 1

Total Depth: 3572

County: Phillips,
Kansas

Comm: 8-27-52 Comp: 9-5-52

Contractor: Glenn W. Peel

Elevation:

Casing:

8 5/8" 210' cem.

Production: Dry

Figures below indicate bottom of formations

Surface Soil	0 -	212
Shale		700
Sand		845
Anhydrite		870
Sand		1270
Red Bed		1495
Anhydrite		1530
Shale		1775
Shale & Shells		2080
Lime & Shale		3100
Lime		3572
Total Depth		3572

This is to certify that the above information is, to the best of our knowledge true and correct.

GLENN W. PEEL

BY: Marvin M. Herbert

SUBSCRIBED AND SWORN to before me this 9th day of September, 1952.

My commission expires June 4, 1955 Marvin M. Herbert
Notary Public

RECEIVED
STATE CORPORATION COMMISSION
SEP 11 1952
CONSERVATION DIVISION
Wichita, Kansas
9-11-52

FILED
FILE SEC 13 T 4 R 19W
BOOK PAGE 43 LINE 8