


15-147-00637-00-00

Give All Information Completely
Make Required Affidavit
Mail or Deliver Report to:
Conservation Division
State Corporation Commission
212 North Market, Insurance Bldg.
Wichita, Kansas

WELL PLUGGING RECORD

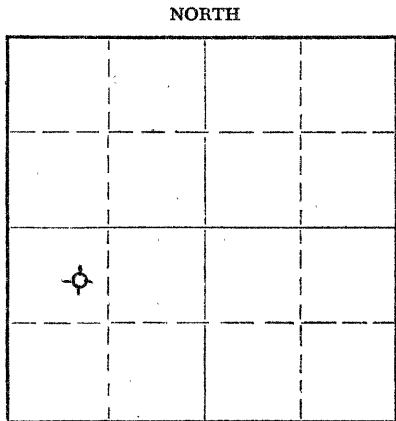

Locate well correctly on above Section Plat

Phillips County, Sec. 30 Twp. 4 Rge. 19 (E) (W)W
Location as "NE/CNW/SW" or footage from lines C E L NW SW
Lease Owner D. G. Hansen
Lease Name Fox Well No#
Office Address Logan, Kansas
Character of Well (completed as Oil, Gas or Dry Hole) Dry Hole
Date well completed December 8 19 60
Application for plugging filed December 8 19 60
Application for plugging approved December 8 19 60
Plugging commenced December 8 19 60
Plugging completed December 8 19 60
Reason for abandonment of well or producing formation Too low structurally

If a producing well is abandoned, date of last production _____ 19____
Was permission obtained from the Conservation Division or its agents before plugging was commenced? Yes

Name of Conservation Agent who supervised plugging of this well Eldon Petty, Hays, Kansas
Producing formation _____ Depth to top _____ Bottom _____ Total Depth of Well 3360 Feet
Show depth and thickness of all water, oil and gas formations.

OIL, GAS OR WATER RECORDS

CASING RECORD

FORMATION	CONTENT	FROM	TO	SIZE	PUT IN	PULLED OUT
				8-5/8"	169'	None

Describe in detail the manner in which the well was plugged, indicating where the mud fluid was placed and the method or methods used in introducing it into the hole. If cement or other plugs were used, state the character of same and depth placed, from _____ feet to _____ feet for each plug set.

Filled hole with heavy mud to 450'. Set plug. Put in 20 sacks cement. Filled to 160'. Set plug. Put in 1/2 sack hulls and 20 sacks cement. Filled with heavy mud up to 40'. Set plug. Filled to top with 1-1/2 sack hulls and 10 sacks cement.

RECEIVED
CONSERVATION DIVISION
Wichita, Kansas
DEC 20 1960

12-20-60

(If additional description is necessary, use BACK of this sheet)
Name of Plugging Contractor C-G Drilling Co.
Address 107 Rule Building, Wichita 2, Kansas


STATE OF KANSAS, COUNTY OF SEDGWICK, ss.
G. F. Galloway (employee of owner) or (owner or operator) of the above-described well, being first duly sworn on oath, says: That I have knowledge of the facts, statements, and matters herein contained and the log of the above-described well as filed and that the same are true and correct. So help me God.

(Signature) G. F. Galloway
107 Rule Building
(Address)

SUBSCRIBED AND SWORN to before me this 12th day of December, 1960

My commission expires May 20, 1963

Vicky Jacobs
Vicky Jacobs Notary Public.

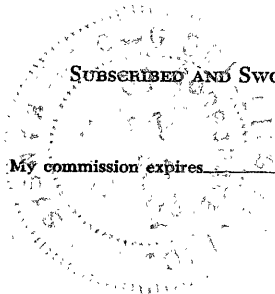

B-147-00637-00-00

W E L L L O G

OPERATOR D. G. Hansen SEC.30-4-19W
 WELL NAME Fox #4 LOC.C E L NW SW
 TOTAL DEPTH 3360' COUNTY Phillips
 COMM. December 1, 1960 COMP.December 8, 1960 STATE Kansas
 RIG NO. 1 ELEVATION 1959' R.B.

CASING: Ran 169' (8 jts.) 8-5/8" OD Surface Casing. PRODUCTION: D & A

All measurements taken from the top of rotary bushing.

FROM	TO	FORMATION	DEVIATION FROM VERTICAL	REMARKS:
0	585	Shale-Sand		
585	770	Sand		
770	1000	Sand-Shale		
1000	1230	Shale-Sand		
1230	1498	Shale-Red Bed		
1498	1540	Anhydrite		
1540	1905	Shale		
1905	2160	Shale-Shell		
2160	2630	Shale-Lime	0° - 2500	
2630	2975	Lime-Shale	0° - 2750	
2975	3050	Shale-Lime	0° - 3000	
3050	3158	Lime-Shale		DST 3147-3148'
3158	3250	Lime	0° - 3250	
3250	3305	Lime-Shale		
3305	3360	Lime		

DEC 20 1960
 CONSERVATION DIVISION
 Wichita, Kansas
 12-20-60

STATE OF KANSAS }
 COUNTY OF SEDGWICK } SS.

The undersigned hereby certifies that to the best of his knowledge and belief, the above facts are true and correct.

C-G DRILLING CO.
 By G. F. Galloway
 G. F. Galloway

SUBSCRIBED AND SWORN TO, BEFORE ME, THIS 12th day of December, 1960.

My commission expires:
 May 20, 1963

Vicky Jacobs
 Vicky Jacobs - Notary public