

15-147-30190-00-01

Give All Information Completely
Make Required Affidavit
Mail or Deliver Report to:
Conservation Division
State Corporation Commission
211 No. Broadway
Wichita, Kansas

WELL PLUGGING RECORD

Phillips County, Sec. 30 Twp. 4-S Rge. 19 ~~(E)~~ W(W)

Location as "NE/CNW/SW" or footage from lines. C S/2 SW/4 NW/4

Lease Owner The R. W. Rine Drilling Company

Lease Name Wilson Well No. #1

Office Address Suite 600 - 300 West Douglas, Wichita, Kansas

Character of Well (completed as Oil, Gas or Dry Hole) Input well

Date well completed May 28 19 68

Application for plugging filed June 5, 19 68

Application for plugging approved June 4 19 68


Plugging commenced May 28 19 68

Plugging completed May 28 19 68

Reason for abandonment of well or producing formation Drill out of old hole for input well, abandoned because unable to drill through old plugging.

If a producing well is abandoned, date of last production 19

Was permission obtained from the Conservation Division or its agents before plugging was commenced? yes

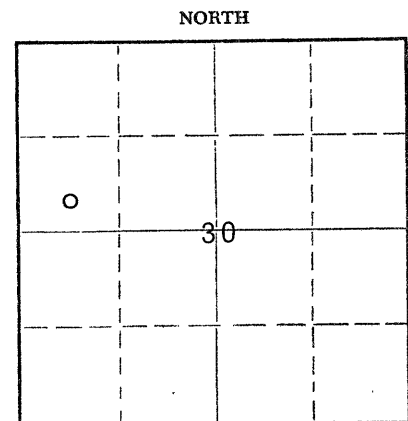

Locate well correctly on above Section Plat

Name of Conservation Agent who supervised plugging of this well Leo Massey, Box 582, Hays, Kansas

Producing formation Depth to top Bottom Total Depth of Well 3186 Feet

Show depth and thickness of all water, oil and gas formations.

OIL, GAS OR WATER RECORDS

CASING RECORD

FORMATION	CONTENT	FROM	TO	SIZE	PUT IN	PULLED OUT

Describe in detail the manner in which the well was plugged, indicating where the mud fluid was placed and the method or methods used in introducing it into the hole. If cement or other plugs were used, state the character of same and depth placed, from feet to feet for each plug set.

Plugged with 70 sacks cement at 765'; 20 sacks cement at 150'; 10 sacks of cement at 40'.

RECEIVED
STATE CORPORATION COMMISSION
JUN 6 1968
CONSERVATION DIVISION
Wichita, Kansas

6-6-68

(If additional description is necessary, use BACK of this sheet)

Name of Plugging Contractor Omega Drilling, Inc.

Address 427 Union Center, Wichita, Kansas

STATE OF KANSAS, COUNTY OF SEDGWICK, ss.

Paul A. Harper (employee of owner) or (owner or operator) of the above-described well, being first duly sworn on oath, says: That I have knowledge of the facts, statements, and matters herein contained and the log of the above-described well as filed and that the same are true and correct. So help me God.

(Signature) Paul A. Harper

300 West Douglas, Wichita, Kansas

(Address)

SUBSCRIBED AND SWORN TO before me this 5th day of June, 1968

My commission expires June 8, 1970

Bette J. Edwards
Bette J. Edwards Notary Public.

