


STATE OF KANSAS  
STATE CORPORATION COMMISSION

15-147-30190-0000  
WELL PLUGGING RECORD

Give All Information Completely  
Make Required Affidavit  
Mail or Deliver Report to:  
Conservation Division  
State Corporation Commission  
800 Biting Building  
Wichita, Kansas

Phillips County. Sec. 30 Twp. 4S Rge. 19 (~~W~~) (W)  
Location as "NE/CNW/SW" or footage from lines Ctr. S/2 SW NW  
Lease Owner The R. W. Rine Drilling Company et al.  
Lease Name Wilson Well No. 1  
Office Address 420 Union Center, Wichita, Kansas  
Character of Well (completed as Oil, Gas or Dry Hole) Dry Hole  
Date well completed August 22, 1960  
Application for plugging filed August 22, 1960  
Application for plugging approved August 22, 1960  
Plugging commenced 11:30 P.M. August 22, 1960  
Plugging completed 7:00 A.M. August 23, 1960  
Reason for abandonment of well or producing formation Dry Hole

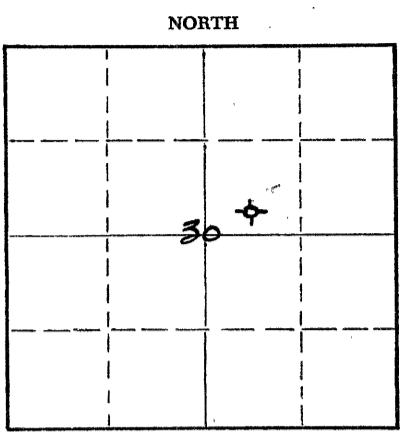

Locate well correctly on above Section Plat

If a producing well is abandoned, date of last production \_\_\_\_\_ 19\_\_\_\_  
Was permission obtained from the Conservation Division or its agents before plugging was commenced? Yes

Name of Conservation Agent who supervised plugging of this well Eldon Petty  
Producing formation \_\_\_\_\_ Depth to top \_\_\_\_\_ Bottom \_\_\_\_\_ Total Depth of Well 3500 Feet  
Show depth and thickness of all water, oil and gas formations.

OIL, GAS OR WATER RECORDS CASING RECORD

FORMATION	CONTENT	FROM	TO	SIZE	PUT IN	PULLED OUT
				8 5/8	133	--

Describe in detail the manner in which the well was plugged, indicating where the mud fluid was placed and the method or methods used in introducing it into the hole. If cement or other plugs were used, state the character of same and depth placed, from \_\_\_\_\_ feet to \_\_\_\_\_ feet for each plug set.

Heavy Rotary Mud was placed to 600' w/drill pipe.  
A wooden plug & 20 sx. of cement were placed at 600'  
Heavy rotary mud to 150'  
A wooden plug & 15 sx. of cement were placed @ 150'  
Heavy rotary mud to 30'  
A wooden plug & 10 sx. of cement to bottom of cellar.

RECEIVED  
STATE CORPORATION COMMISSION  
AUG 29 1960  
CONSERVATION DIVISION  
Wichita, Kansas  
829-600

(If additional description is necessary, use BACK of this sheet)  
Name of Plugging Contractor Stickle Drilling Co.  
Address 1100 Biting Bldg., Wichita 2, Kansas

STATE OF KANSAS COUNTY OF SEDGWICK, ss.  
R. M. Green (employee of owner) or (~~owner or operator~~) of the above-described well, being first duly sworn on oath, says: That I have knowledge of the facts, statements, and matters herein contained and the log of the above-described well as filed and that the same are true and correct. So help me God.

(Signature) R. M. Green  
Secretary-Treasurer  
420 Union Center, Wichita, Kansas  
(Address)

SUBSCRIBED AND SWORN TO before me this 26th day of August, 19 60  
John E. Hale  
Notary Public.

My commission expires 6/14/62



604

15-147-30140

R. W. Rine Drilling Company  
Wichita, Kansas

Tulsa, Oklahoma  
August 26, 1960

Contractor: Stickle Drilling Company  
Date Commenced: August 15, 1960  
Date Completed: August 23, 1960

Wilson Well No. 1,  
Ctr. S/2 SW NW of  
Sec. 30-4S-19W.,  
Phillips Co., Kansas

DRILLER'S LOG

Depth Figures Indicate Base of Formation:

Shale & shells	134
Shale	600
Sand & shale	1050
Sand	1220
Sand, shale & red bed	1498
Anhydrite	1530
Shale & shells	2420
Shale & lime	2945
Lime & shale	3145
Lime	3370
Lm., chert & conglomerate	3480
Conglomerate & Arbuckle	3500 TD

I, Fred E. Stickle, hereby certify the above to be a true and complete Driller's Log of Rine Drilling Company's Wilson Well No. 1, center S/2 SW NW of Section 30-4S-19W., Phillips County, Kansas.

Fred E. Stickle  
Fred E. Stickle

Edith A. Lawver  
Notary Public

My commission expires March 24, 1964.

RECEIVED  
STATE CORPORATION COMMISSION

AUG 29 1960

829-60

CONSERVATION DIVISION  
Wichita, Kansas