


15-147-00122-00-00

STATE OF KANSAS
STATE CORPORATION COMMISSION

Give All Information Completely
Make Required Affidavit
Mail or Deliver Report to:
Conservation Division
State Corporation Commission
800 Bittling Building
Wichita, Kansas

WELL PLUGGING RECORD

NORTH

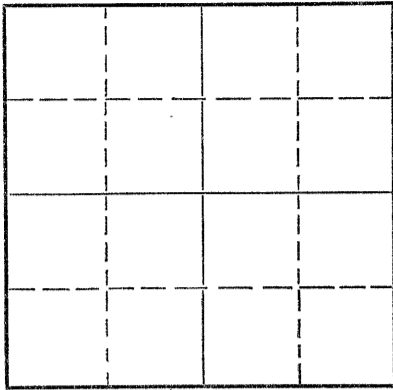

Locate well correctly on above
Section Plat

Phillips County. Sec. 21 Twp. 4S Rge. 19 (E) W(W)

Location as "NE/CNW%SW%" or footage from lines SE SE NE

Lease Owner J. J. Lynn

Lease Name Fischli Well No. 1

Office Address Box 2199, Abilene, Texas

Character of Well (completed as Oil, Gas or Dry Hole) Dry Hole

Date well completed July 31 19 54

Application for plugging filed July 31 19 54

Application for plugging approved July 31 19 54

Plugging commenced July 31 19 54

Plugging completed July 31 19 54

Reason for abandonment of well or producing formation Dry Hole

If a producing well is abandoned, date of last production 19

Was permission obtained from the Conservation Division or its agents before plugging was commenced? Yes

Name of Conservation Agent who supervised plugging of this well Eldon Petty

Producing formation Depth to top Bottom Total Depth of Well 3550' Feet

Show depth and thickness of all water, oil and gas formations.

OIL, GAS OR WATER RECORDS

CASING RECORD

FORMATION	CONTENT	FROM	TO	SIZE	PUT IN	PULLED OUT
				8-5/8"	200'	

Describe in detail the manner in which the well was plugged, indicating where the mud fluid was placed and the method or methods used in introducing it into the hole. If cement or other plugs were used, state the character of same and depth placed, from feet to feet for each plug set.

Filled hole with heavy mud through drill pipe. Set bottom plug at 190' with 15 sacks of cement. Filled hole with mud to 40' of the surface, cemented to top with 10 sacks of cement.

STATE OF KANSAS
CONSERVATION DIVISION
WICHITA, KANSAS

8-5-54

(If additional description is necessary, use BACK of this sheet)

Name of Plugging Contractor Group Exploration Company

Address Sterling, Kansas

STATE OF KANSAS, COUNTY OF RICE, ss.

Rollin Mead (employee of owner) or (owner or operator) of the above-described

well, being first duly sworn on oath, says: That I have knowledge of the facts, statements, and matters herein contained and the log of the above-described well as filed and that the same are true and correct. So help me God.

(Signature) Rollin Mead

Sterling, Kansas (Address)


SUBSCRIBED AND SWORN TO before me this 3rd day of August, 19 54

My Commission Expires Sept. 17, 1957

My commission expires Notary Public.

24-7368-S 3-53-20M

My Commission Expires Sept. 17, 1957

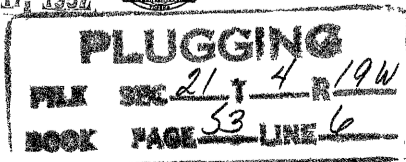

15-147-00122-00-00

GROUP EXPLORATION CO.

BOX 218
STERLING, KANSAS

WELL LOG

FISCHLI #1

Location: SE SE NE, Section 21-4S-19W,
Phillips County, Kansas

OWNER: J. J. Lynn
ROTARY DRILLING CONTRACTOR: Group Exploration Company

COMMENCED: 7-20-54 (w.r.)

COMPLETED: 7-31-54 (w.r.)

TOTAL DEPTH: 3550' (w.r.)

LOG

0-675	Shale
675-800	Sand
800-900	Shale
900-1360	Sand & Shells
1360-1625	Shale & Lime
1625-2045	Shale & Shells
2045-2090	Lime
2090-2250	Lime & Shale
2250-2450	Lime
2450-2775	Shale & Lime
2775-2875	Shale & Shells
2875-3065	Shale & Lime
3065-3500	Lime
3500-3550	Lime & Shale, T.D.

CASING RECORD

Ran 200' of 8-5/8" casing, set with
150 sacks of cement.

PRODUCTION

Plugged & Abandoned

RECEIVED
CORPORATION COMMISSION

AUG 3 1954

EXPLORATION DIVISION
Sterling, Kansas

8-5-54

