


15-147-0085-00-00

STATE OF KANSAS
STATE CORPORATION COMMISSION

WELL PLUGGING RECORD

Give All Information Completely
Make Required Affidavit
Mail or Deliver Report to:
Conservation Division
State Corporation Commission
800 Bittling Building
Wichita, Kansas

NORTH

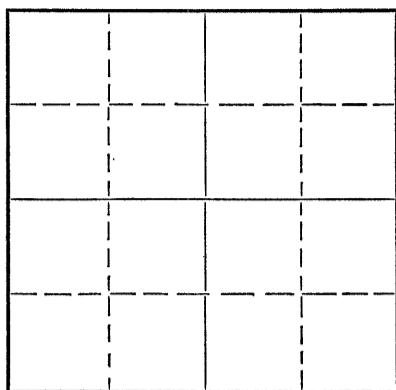

Locate well correctly on above
Section Plat

Phillips County. Sec. 35 Twp. 4S Rge. (E) 19 (W)
Location as "NE/CNW 1/4 SW 1/4" or footage from lines NW NW SE
Lease Owner Westgate-Greenland Oil Company
Lease Name Seeger Well No. 1
Office Address 1009 Central Building, Wichita 2, Kansas
Character of Well (completed as Oil, Gas or Dry Hole) dry hole
Date well completed May 17, 1951 19
Application for plugging filed (Orally) May 17, 1951 19
Application for plugging approved (written) May 19, 1951 19
Plugging commenced May 17, 1951 19
Plugging completed May 17, 1951 19
Reason for abandonment of well or producing formation

If a producing well is abandoned, date of last production 19
Was permission obtained from the Conservation Division or its agents before plugging was commenced? yes

Name of Conservation Agent who supervised plugging of this well Eldon Petty
Producing formation Depth to top Bottom Total Depth of Well Feet
Show depth and thickness of all water, oil and gas formations.

OIL, GAS OR WATER RECORDS

CASING RECORD

Formation	Content	From	To	Size	Put In	Pulled Out
Surface		0	203	8 5/8"	203	none

Describe in detail the manner in which the well was plugged, indicating where the mud fluid was placed and the method or methods used in introducing it into the hole. If cement or other plugs were used, state the character of same and depth placed, from feet to feet for each plug set.

Filled hole with heavy mud from 3553 to 205 feet
Set plug and ran 15 sacks cement to 160 feet
Filled with heavy mud from 160 feet to 40 feet
Set plug at 40 feet and ran 10 sacks cement to cellar base

RECEIVED
STATE CORPORATION COMMISSION
MAY 23 1951
CONSERVATION DIVISION
Wichita, Kansas
5-23-51

(If additional description is necessary, use BACK of this sheet)

Correspondence regarding this well should be addressed to Westgate-Greenland Oil Company
Address 1009 Central Building, Wichita 2, Kansas

STATE OF Kansas, COUNTY OF Sedgwick, ss.
G. E. Bitler (employee of owner) or (owner or operator) of the above-described well,
being first duly sworn on oath, says: That I have knowledge of the facts, matters and matters herein contained and the log of the above-described well as filed and that the same are true and correct. So help me God.

(Signature) G. E. Bitler
1009 Central Building, Wichita 2, Kansas
(Address)

SUBSCRIBED AND SWORN to before me this 22nd day of May, 19 51
Esther Unsell
Notary Public.

My commission expires May 25, 1953

PLUGGING
FILE SEC 35 T 4 R 19
BOOK PAGE 83 LINE 7

15-147-00085-00-00

COMPANY: Westgate Greenland Oil Co.
 CONTRACTOR: Jackson Drilling Corporation
 FARM: Seeger #1
 LOCATION: NW NW SE Section 35-4-19W
 Phillips County, Kansas
 ELEVATION: 1854
 COMMENCED: May 8, 1951
 COMPLETED: May 17, 1951

0	to	10	Cellar
10	to	90	Sand
90	to	100	Shale
100	to	530	Shale & shells
530	to	610	Shale w/ sand strks.
610	to	635	Red bed & shale
635	to	680	Sand
680	to	700	Shale
700	to	745	Sand
745	to	760	Shale
760	to	1190	Shale & sand
1190	to	1245	Red bed & shale
1245	to	1465	Red bed
1465	to	1505	Anhydrite
1505	to	1750	Shale & red bed
1750	to	1905	Shale & shells
1905	to	2889	Shale & lime
2889	to	2930	Topeka Lime
2930	to	3155	Lime & shale
3155	to	3375	Lime
3375	to	3399	Shale (Cong.)
3399	to	3480	Lime & shale
3480	to	3507	Conglomerate
3507	to	3553	Lime
		3553	T.D.

8 5/8" - 21# casing set at 203 feet. Cemented with 140 sacks cement and 2 sacks calcium chloride.
 Drill stem test at 3330 feet. Open 1/2 hour - recovered 30 feet heavily oil cut mud.

Tops - Anhydrite 1467
 Heebner 3112
 Toronto 3138
 Lansing 3158
 Arbuckle 3507

RECEIVED
 STATE CORPORATION COMMISSION

MAY 25 1951

5-25-51

CONSERVATION DIVISION
 Wichita, Kansas

Dry and abandoned.

All measurements from top of derrick floor.

C E R T I F I C A T E

I, Clare A. Stewart, do hereby certify that the above and foregoing is a true and correct copy of log of the Seeger #1, Section 35-4-19W, Phillips County, Kansas, as reflected by files of the Jackson Drilling Corporation.

Clare A. Stewart
 Clare A. Stewart

Subscribed and sworn to before me, a Notary Public, within and for Johnson County, Kansas, this 23rd day of May, 1951.

Naomi Mendus
 Naomi Mendus

My Commission expires May 3, 1951.

PLUGGING
 FILE SEC 35 T 4 R 19 W
 BOOK PAGE 83 LINE 7