

15-147-00017-00/00

STATE OF KANSAS  
STATE CORPORATION COMMISSION

WELL PLUGGING RECORD

Give All Information Completely  
Make Required Affidavit  
Mail or Deliver Report to:  
Conservation Division  
State Corporation Commission  
800 Bittling Building  
Wichita, Kansas

OR

FORMATION PLUGGING RECORD

Strike out upper line  
when reporting plug-  
ging off formations.

SE SE SE County. Sec. 2 Twp. 4S Rge. 19 (E) W (W)

Location as "NE 1/4 NW 1/4 SW 1/4" or footage from lines

Lease Owner Stanolind Oil and Gas Company

Lease Name Fritz Brenneke Well No. 1

Office Address Box 591, Tulsa, Oklahoma

Character of Well (completed as Oil, Gas or Dry Hole) Dry Hole

Date well completed 12-5 19 46

Application for plugging filed 12-5 19 46

19 W Application for plugging approved (Verbal) 12-5 19 46


Plugging commenced 12-6 19 46

Plugging completed 12-7 19 46

Reason for abandonment of well or producing formation Well drilled to Granite Formation with no commercial production found.

If a producing well is abandoned, date of last production - 19

Was permission obtained from the Conservation Division or its agents before plugging was commenced? Yes

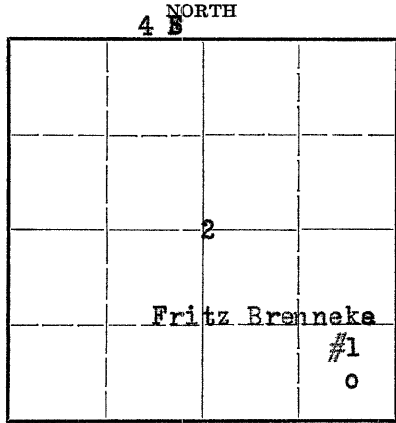

Locate well correctly on above Section Plat

Name of Conservation Agent who supervised plugging of this well H. W. Kerr

Producing formation Arbuckle Depth to top 3598 Bottom - Total Depth of Well 3788 Feet

Show depth and thickness of all water, oil and gas formations. Reagan Sand not present.

OIL, GAS OR WATER RECORDS


CASING RECORD

Formation	Content	From	To	Size	Put In	Pulled Out
Lansing			3266	13-3/8 OD	149	None
Arbuckle			3598			
Granite			3756			

Describe in detail the manner in which the well was plugged, indicating where the mud fluid was placed and the method or methods used in introducing it into the hole. If cement or other plugs were used, state the character of same and depth placed, from feet to feet for each plug set.

Filled hole with heavy mud from TD 3788 to 150, set wood plug at 150, dumped 20 sacks cement to 130. Mudded hole from 130 to 16 feet and dumped 10 sacks cement from 16 feet to bottom of cellar as surface plug.

PLUGGING  
FILE NO. 2 4 19W  
BOOK PAGE 95 LINE 43

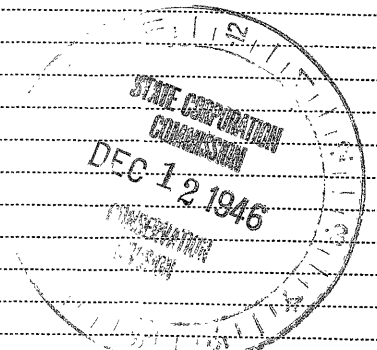

12-12-46

(If additional description is necessary, use BACK of this sheet)

Correspondence regarding this well should be addressed to G. A. Younie

Address Box 35 Gorham, Kansas

STATE OF KANSAS COUNTY OF RUSSELL, ss.

G. A. Younie (employee of owner) or (owner) of the above-described well,

being first duly sworn on oath, says: That I have knowledge of the facts, statements, and matters herein contained and the log of the above-described well as filed and that the same are true and correct. So help me God.

(Signature) G. A. Younie Field Supt.

Box 35, Gorham, Kansas (Address)

SUBSCRIBED AND SWORN to before me this 9 day of December, 19 46

My commission expires 12-31-49

R. J. Seymour Notary Public.

15-147-0007-00-00

STANOLIND OIL AND GAS COMPANY

WELL RECORD

TWP. 4 3 N OR S

SUPPLEMENTAL (ENTER "X" WHEN APPLICABLE)

Grid for well location with handwritten '2' in the center.

LEASE Frits Brannake WELL NO. 1

LOCATION OF WELL: 480 FT. NORTH SOUTH OF THE 320 FT.

EAST WEST OF THE EAST WEST LINE OF THE 1/4 1/4 1/4

OF SECTION 2 TOWNSHIP 4 NORTH SOUTH, RANGE 19 EAST WEST.

Phillips Kansas COUNTY STATE

ELEVATION: 1998 Derrick Floor

COMPLETED AS: OIL WELL GAS WELL WATER WELL DRY HOLE

DRILLING: COMMENCED 11-16 46 COMPLETED 12-5 46

LOCATE WELL CORRECTLY

OPERATING COMPANY Stanolind Oil and Gas Company ADDRESS Box 561, Tulsa, Oklahoma

OIL OR GAS SANDS OR ZONES

Table with columns: NAME, FROM, TO, NAME, FROM, TO. Rows include Lansing, Arbuckle, Granite (Weathered).

WATER SANDS

Table with columns: NAME, FROM, TO, WATER LEVEL, NAME, FROM, TO, WATER LEVEL.

CASING RECORD (OVERALL MEASUREMENT)

LINER-SCREEN RECORD

Table for casing and liner-screen records with columns for size, weight, description, quantity, size, quantity, set at, make and type.

PACKER RECORD

Table for packer record with columns for size, length, set at, make and type.

CEMENTING RECORD

MUDDING RECORD

Table for cementing and mudding records with columns for size, where set, cement, method, final press, method, results.

WHAT METHOD WAS USED TO PROTECT SANDS WHEN OUTER STRINGS WERE PULLED? None Pulled

WERE BOTTOM HOLE PLUGS USED?

IF SO, STATE KIND, DEPTH SET, AND RESULTS OBTAINED

ROTARY TOOLS WERE USED FROM 0 FEET TO 3700 FEET, AND FROM FEET TO FEET

CABLE TOOLS WERE USED FROM FEET TO FEET, AND FROM FEET TO FEET


24-HOUR PRODUCTION OR POTENTIAL TEST Abandoned in Granite Formation

IF GAS WELL, CUBIC FEET PER 24 HOURS SHUT-IN PRESSURE LBS. PER SQUARE IN.

I, THE UNDERSIGNED, BEING FIRST DULY SWORN UPON OATH, STATE THAT THIS WELL RECORD IS TRUE AND CORRECT...

SUBSCRIBED AND SWORN TO BEFORE ME THIS 10 DAY OF December 19 46

MY COMMISSION EXPIRES 12-31-49

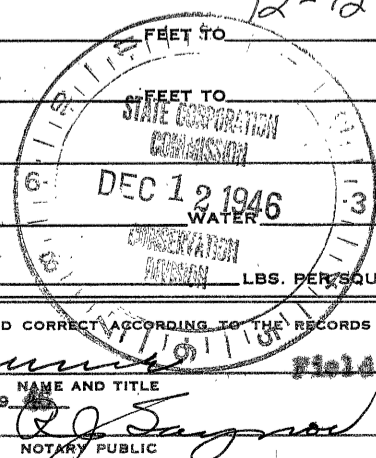


FORMATION RECORD

DESCRIBE EACH FORMATION DRILLED. INDICATE THICKNESS, CONTENT AND WHETHER DRY, OR OIL, GAS, OR WATER BEARING.

FORMATION	TOP	BOTTOM	FORMATION	TOP	BOTTOM
Surface Soil	0	40			
Clay and Sand	40	162			
Shale and Shells	162	1035			
Sandy Shale and Shells	1035	1545			
Shale	1545	1820			
Shale and Shells	1820	2180			
Shale and Lime	2180	2690			
Lime	2690	2740			
Lime and Shale	2740	2805			
Conglomerate	2805	2844			
Lime and Shale	2844	3047			
Lime	3047	3140			
Lime and Shale	3140	3170			
Lime	3170	3200			
Lime and Shale	3200	3227			
Lime	3227	3359			
Lime and Shale	3359	3375			
Lime and Chert	3375	3421			
Lime	3421	3423			
Lime - Core #1 - 3419 to 21 full recovery, 1 1/2' gray fine x lime lime, 6" gray shale no show DST, tool open 1 hour, recovered 30' drill- ing mud, no oil	3423	3463			
Cherty Lime and Shale	3463	3600			
Lime and Shale	3600	3626			
Lime - DST - two runs w/ packer, recovered 2' mud in 20 minutes	3626	3727			
Lime - DST, tool open 15 minutes, recovered 360' mud 1140' water	3727	3756			
Dolomite	3756	3788			
Granite Wash	TD	3788			
Granite (quartzite)					
Location Staked	11- 4-46				
Date First Work	11-10-46				
Drilling Commenced	11-16-46				
Drilling Completed	12- 5-46				
Dry Hole Completion	12- 5-46				
Plugging Completed	12- 7-46				

# STANOLIND OIL AND GAS COMPANY

Gorham, Kansas  
December 10, 1946

15-147-00017-00-00

File: G-1067-86

Re: Well and Formation Plugging Record  
Fritz Brenneke No. 1

Kansas State Corporation Commission  
Conservation Division  
800 Bitting Building  
Wichita, Kansas


Gentlemen:

We are forwarding herewith original copy of Well and Formation Plugging Record and copy of Well Record covering drilling and completion of our Fritz Brenneke No. 1, Phillips County, Kansas, as a dry hole.

Yours very truly,

*G. A. Younis*  
G. A. Younis

RJG:lbc  
cc: T. L. Regan  
L. K. Worth

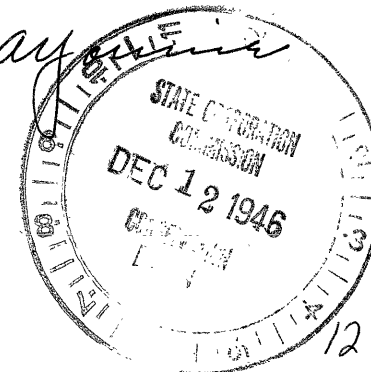

12-12-46