

15-147-20097-00-00


STATE OF KANSAS  
STATE CORPORATION COMMISSION

Form CP-4

Give All Information Completely  
Make Required Affidavit  
Mail or Deliver Report to:  
Conservation Division  
State Corporation Commission  
212 No. Market  
Wichita, Kansas 67202

WELL PLUGGING RECORD

NORTH

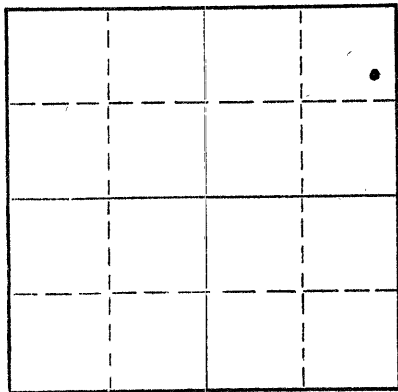

Locate well correctly on above  
Section Plat

Phillips County. Sec. 1 Twp. 4S Rge. 19 (E) W (W)  
Location as "NE/CNWxSWx" or footage from lines SE NE NE  
Lease Owner Petroleum Management, Inc.  
Lease Name Gipe Well No. 2  
Office Address 1515 Wichita Plaza, Wichita, Kansas 67202  
Character of Well (completed as Oil, Gas or Dry Hole) D&A  
Date well completed June 23, 1970  
Application for plugging filed June 23, 1970  
Application for plugging approved June 23, 1970  
Plugging commenced June 23, 1970  
Plugging completed June 23, 1970  
Reason for abandonment of well or producing formation D&A

If a producing well is abandoned, date of last production 19  
Was permission obtained from the Conservation Division or its agents before plugging was commenced? Yes

Name of Conservation Agent who supervised plugging of this well Leo F. Massey  
Producing formation \_\_\_\_\_ Depth to top \_\_\_\_\_ Bottom \_\_\_\_\_ Total Depth of Well 3496 Feet  
Show depth and thickness of all water, oil and gas formations.

OIL, GAS OR WATER RECORDS

CASING RECORD

| FORMATION | CONTENT | FROM | TO | SIZE   | PUT IN  | PULLED OUT |
|-----------|---------|------|----|--------|---------|------------|
|           |         |      |    | 8 5/8" | 204.96' | =0-        |
|           |         |      |    |        |         |            |
|           |         |      |    |        |         |            |
Describe in detail the manner in which the well was plugged, indicating where the mud fluid was placed and the method or methods used in introducing it into the hole. If cement or other plugs were used, state the character of same and depth placed, from \_\_\_\_\_ feet to \_\_\_\_\_ feet for each plug set.

Plug #1 @ 720' w/70 sx cement  
Plug #2 @ 210' w/20 sx cement  
Bridge @ 40' w/10 sx cement

RECEIVED  
STATE CORPORATION COMMISSION  
JUN 29 1970  
CONSERVATION DIVISION  
Wichita, Kansas

6-29-70

(If additional description is necessary, use BACK of this sheet)  
Name of Plugging Contractor Red Tiger Drilling Company  
Address 1720 Wichita Plaza, Wichita, Kansas 67202

STATE OF Kansas, COUNTY OF Sedgwick, ss.  
Jim Farrice (employee of owner) or (owner or operator) of the above-described well, being first duly sworn on oath, says: That I have knowledge of the facts, statements, and matters herein contained and the log of the above-described well as filed and that the same are true and correct. So help me God.

(Signature) Jim Farrice  
1720 Wichita Plaza, Wichita, Kansas 67202 (Address)

SUBSCRIBED AND SWORN to before me this 25th day of June, 1970



Gloria Fawcett  
Notary Public.