

15-47-00194-00-00

WELL PLUGGING RECORD

Give All Information Completely
Make Required Affidavit
Mail or Deliver Report to:
Conservation Division
State Corporation Commission
800 Biting Building
Wichita, Kansas

Phillips

County. Sec. 9 Twp. 4S Rge. (E) 19(W)

Location as "NE/CNW4SW4" or footage from lines SW SE SE

Lease Owner Shawver-Armour, Inc.

Lease Name 817 Central Building, Wichita, Kansas Well No. Roeder #1

Office Address 817 Central Building, Wichita, Kansas

Character of Well (completed as Oil, Gas or Dry Hole)

Date well completed 10-2-55 19

Application for plugging filed 10-2-55 19

Application for plugging approved 10-2-55 19


Plugging commenced 10-2-55 19

Plugging completed 10-2-55 19

Reason for abandonment of well or producing formation Dry Hole

If a producing well is abandoned, date of last production None 19

Was permission obtained from the Conservation Division or its agents before plugging was commenced? Yes

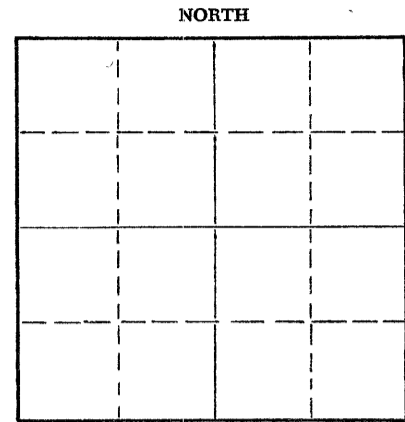

Locate well correctly on above
Section Plat

Name of Conservation Agent who supervised plugging of this well Eldon Petty

Producing formation Kansas City Depth to top 3323 Bottom 3527 Total Depth of Well 3530 Feet

Show depth and thickness of all water, oil and gas formations.

OIL, GAS OR WATER RECORDS

CASING RECORD

FORMATION	CONTENT	FROM	TO	SIZE	PUT IN	PULLED OUT
Surface	Water	0	183	8-5/8	183	None

Describe in detail the manner in which the well was plugged, indicating where the mud fluid was placed and the method or methods used in introducing it into the hole. If cement or other plugs were used, state the character of same and depth placed, from _____ feet to _____ feet for each plug set.

Heavy mud to 170' and set wooden plug @ 170'. 1/2 sx hulls on top of plug, 15 sx cement through drill pipe on top of plug. Heavy mud to 40' and set second wooden plug with 1/2 sx of hulls on top of plug. Filled hole to base of cellar w/ 10 sx cement.

(If additional description is necessary, use BACK of this sheet)

Name of Plugging Contractor Garvey Drilling Co.

Address Derby Building Wichita

STATE OF Kansas, COUNTY OF Sedgwick, ss.

James Armour (employee of owner) or (owner or operator) of the above-described well, being first duly sworn on oath, says: That I have knowledge of the facts, statements, and matters herein contained and the log of the above-described well as filed and that the same are true and correct. So help me God.

(Signature) James Armour


817 Central Building

(Address)

SUBSCRIBED AND SWORN TO before me this 5 day of Oct., 19 55

Rosemary Penrose
Rosemary Penrose Notary Public.

My commission expires March 30, 1957

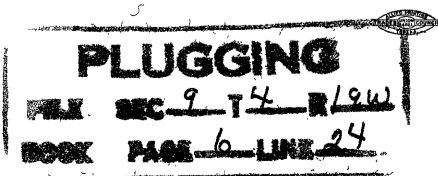

RECEIVED
STATE CORPORATION COMMISSION

NOV 12 1955

11-12-55

CONSERVATION DIVISION
Wichita, Kansas