


STATE OF KANSAS
STATE CORPORATION COMMISSION

15-147-20128-00-09 Form CP-4

WELL PLUGGING RECORD

Give All Information Completely
Make Required Affidavit
Mail or Deliver Report to:
Conservation Division
State Corporation Commission
212 No. Market
Wichita, Kansas

NORTH

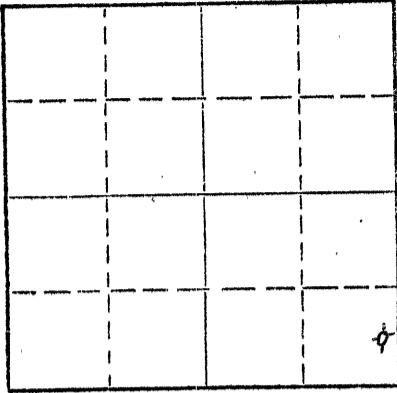

Locate well correctly on above
Section Plat

Phillips County, Sec. 4 Twp. 4S Rge. 19 (X) W (W)
Location as "NE/CNW/SE" or footage from lines. C E/2 SE SE
Lease Owner Woodman-Iannitti Drilling Co.
Lease Name Bach Well No. 1
Office Address 706 Union Natl. Bldg. Wichita, Kansas 67202
Character of Well (completed as Oil, Gas or Dry Hole) D & A
Date well completed 9-4 19 71
Application for plugging filed 9-4 19 71
Application for plugging approved 9-4 19 71
Plugging commenced 9-4 19 71
Plugging completed 9-4 19 71
Reason for abandonment of well or producing formation D & A

If a producing well is abandoned, date of last production 19
Was permission obtained from the Conservation Division or its agents before plugging was commenced? Yes

Name of Conservation Agent who supervised plugging of this well Leo Massey, Hays, Kansas
Producing formation _____ Depth to top _____ Bottom _____ Total Depth of Well 3350 Feet
Show depth and thickness of all water, oil and gas formations.

OIL, GAS OR WATER RECORDS

CASING RECORD

FORMATION	CONTENT	FROM	TO	SIZE	PUT IN	PULLED OUT

Describe in detail the manner in which the well was plugged, indicating where the mud fluid was placed and the method or methods used in introducing it into the hole. If cement or other plugs were used, state the character of same and depth placed, from _____ feet to _____ feet for each plug set.

720' w/70 SXS
180' w/20 SXS
40' w/10 SXS

RECEIVED
STATE CORPORATION COMMISSION
SEP 16 1971
CONSERVATION DIVISION
Wichita, Kansas


9-16-71

(If additional description is necessary, use BACK of this sheet)
Name of Plugging Contractor Murfin Drilling Company
Address 617 Union Center, Wichita, Kansas 67202

STATE OF Kansas, COUNTY OF Sedgwick, ss.
James R. Daniels (employee of owner) or (owner or operator) of the above-described well, being first duly sworn on oath, says: That I have knowledge of the facts, statements, and matters herein contained and the log of the above-described well as filed and that the same are true and correct. So help me God.

(Signature) James R. Daniels
617 Union Center, Wichita, Kansas 67202
(Address)

Subscribed and Sworn to before me this 14th day of September, 1971

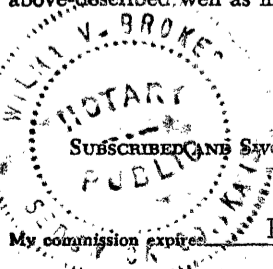

Wilma V. Brokes
Wilma V. Brokes Notary Public.