

15-137-20275-00-00

STATE OF KANSAS
STATE CORPORATION COMMISSION

WELL PLUGGING RECORD

Give All Information Completely
Make Required Affidavit
Mail or Deliver Report to
Conservation Division
State Corporation Comm.
245 North Water
Wichita, KS 67202

Norton County, Sec. 25 Twp. 4S Rge. 23W E/W
Location as "NE/CNW $\frac{1}{4}$ SW $\frac{1}{4}$ " or footage from lines _____

NE SW NE
Lease Owner F & M OIL CO., INC.
Lease Name Sproul "A" Well No. 1

Office Address 422 Union Center, Wichita, Ks. 67202


Character of Well (Completed as Oil, Gas or Dry Hole)
Dry Hole

Date Well completed March 21, 1983
Application for plugging filed March 21, 1983
Application for plugging approved March 21, 1983
Plugging commenced March 21, 1983
Plugging completed March 21, 1983
Reason for abandonment of well or producing formation _____

Dry
If a producing well is abandoned, date of last production 19 _____

Was permission obtained from the Conservation Division or its agents before plugging was commenced? Yes

Name of Conservation Agent who supervised plugging of this well Marion Schmidt
Producing formation _____ Depth to top _____ Bottom _____ Total Depth of Well 3780'
Show depth and thickness of all water, oil and gas formations.

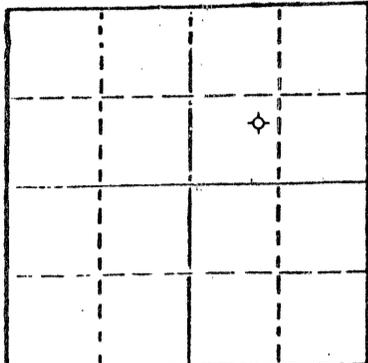

Locate well correctly on above Section Plat

OIL, GAS OR WATER RECORDS

CASING RECORD

FORMATION	CONTENT	FROM	TO	SIZE	PUT IN	PULLED OUT

Describe in detail the manner in which the well was plugged, indicating where the mud fluid was placed and the method or methods used in introducing it into the hold. If cement or other plugs were used, state the character of same and depth placed, from _____ feet to _____ feet for each plug set.

Set 1st plug @ 1925' w/20 sxs
Set 2nd plug @ 1171' w/100 sxs
Set 3rd plug @ 330' w/40 sxs
Set 4th plug @ 40' w/10 sxs
10 sxs in the rat hole, 50/50 posmix, 6% gel, 3% CC
plug down @ 1:30 AM 3-21-83

(If additional description is necessary, use BACK of this sheet)

Name of Plugging Contractor Union Drilling Co., Inc.

STATE OF Kansas COUNTY OF Sedgwick, ss.
R. D. Messinger (employee of owner) or (owner or operator)
of the above-described well, being first duly sworn on oath, says: That I have knowledge of the facts, statements, and matters herein contained and the log of the above-described well as filed and that the same are true and correct. So help me God.

(Signature) R. D. Messinger
422 Union Center, Wichita, Ks. 67202
(Address)

SUBSCRIBED AND SWORN TO before me this 6th day of April, 19 83

My commission expires 12-24-84 Shirley A. Gallegos Notary Public.

RECEIVED
STATE CORPORATION COMMISSION
4-14-83
APR 14 1983