


Give All Information Completely
Make Required Affidavit
Mail or Deliver Report to:
Conservation Division
State Corporation Commission
212 No. Market
Wichita, Kansas

WELL PLUGGING RECORD

NORTH

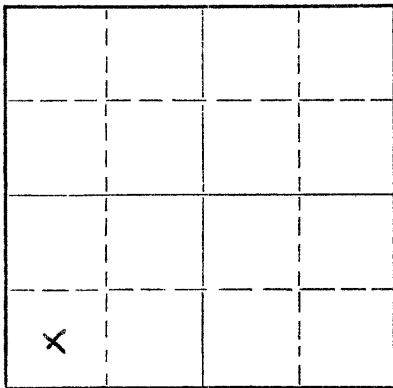

Locate well correctly on above
Section Plat

Norton County. Sec. 23 Twp. 4S Rge. 1E/23 (W)
Location as "NE/CNW%SW%" or footage from lines. C SW SW
Lease Owner S Abercrombie Drilling, Inc. & Lario Oil & Gas Company
Lease Name DOOLITTLE Well No. 1
Office Address 801 Union Center; Wichita, Kansas
Character of Well (completed as Oil, Gas or Dry Hole) Dry hole
Date well completed October 11, 19 69
Application for plugging filed (verbally) October 11, 19 69
Application for plugging approved (verbally) October 11, 19 69
Plugging commenced October 11, 19 69
Plugging completed October 11, 19 69
Reason for abandonment of well or producing formation Dry hole

If a producing well is abandoned, date of last production 19
Was permission obtained from the Conservation Division or its agents before plugging was commenced? Yes

Name of Conservation Agent who supervised plugging of this well Bill Nichols
Producing formation Depth to top Bottom Total Depth of Well 3830 Feet
Show depth and thickness of all water, oil and gas formations.

OIL, GAS OR WATER RECORDS

CASING RECORD

FORMATION	CONTENT	FROM	TO	SIZE	PUT IN	PULLED OUT
				8-5/8"	286'	None

Describe in detail the manner in which the well was plugged, indicating where the mud fluid was placed and the method or methods used in introducing it into the hole. If cement or other plugs were used, state the character of same and depth placed, from feet to feet for each plug set.

Set 1st plug @1360' w/70 sx. cement;
Set 2nd plug @ 285' w/20 sx. cement;
Set top plug @ 40'/w/10 sx. cement.
Job completed at 6:00 p.m., 10-11-69.

RECEIVED
STATE CORPORATION COMMISSION
OCT 14 1969
CONSERVATION DIVISION
Wichita, Kansas

10-14-69

(If additional description is necessary, use BACK of this sheet)

Name of Plugging Contractor Abercrombie Drilling, Inc.
Address (office) 801 Union Center; Wichita, Kansas

STATE OF KANSAS, COUNTY OF SEDGWICK, ss.
Jack K. Wharton (employee of owner) of the above-described well, being first duly sworn on oath, says: That I have knowledge of the facts, statements, and matters herein contained and the log of the above-described well as filed and that the same are true and correct. So help me God.

(Signature)

Jack K. Wharton

801 Union Center; Wichita, Kansas

(Address)

SUBSCRIBED AND SWORN TO before me this 13th day of October, 19 69

My commission expires July 15, 1972

Sue J. Blunck

Sue J. Blunck,

Notary Public.