

15-137-20672-00-00

STATE OF KANSAS
STATE CORPORATION COMMISSION


Form CP-4

WELL PLUGGING RECORD

Give All Information Completely
Make Required Affidavit
Mail or Deliver Report to:
Conservation Division
State Corporation Commission
212 No. Market
Wichita, Kansas 67202

Norton County, Sec. 11 Twp. 4S Rge. (E) 23 (W)

Location as "NE/CNW%SW%" or footage from lines NW NW NW
Lease Owner Okmar Oil Company
Lease Name Harting Well No. 1
Office Address 1130 Wichita Plaza, Wichita, Ks.
Character of Well (completed as Oil, Gas or Dry Hole) Dry Hole
Date well completed May 30, 1971
Application for plugging filed 19
Application for plugging approved 19
Plugging commenced May 30, 1971
Plugging completed May 30, 1971
Reason for abandonment of well or producing formation Dry Hole

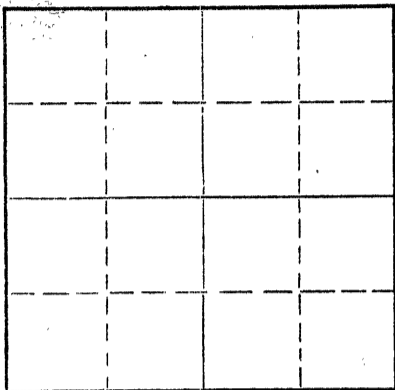

Locate well correctly on above Section Plat

If a producing well is abandoned, date of last production 19

Was permission obtained from the Conservation Division or its agents before plugging was commenced? Yes (W. L. Nichols of Morland)

Name of Conservation Agent who supervised plugging of this well

Producing formation Depth to top Bottom Total Depth of Well 3714 Feet

Show depth and thickness of all water, oil and gas formations.

OIL, GAS OR WATER RECORDS

CASING RECORD

FORMATION	CONTENT	FROM	TO	SIZE	PUT IN	PULLED OUT
	Surface	0	328'	8-5/8"	328'	----
	Casing					

Describe in detail the manner in which the well was plugged, indicating where the mud fluid was placed and the method or methods used in introducing it into the hole. If cement or other plugs were used, state the character of same and depth placed, from feet to feet for each plug set.

Heavy Mud from Total Depth to 1200 Feet;
Plug & 70 sax Cement; Mud to 340 Feet;
Plug & 20 sax Cement; Mud to 40 Feet;
1/2 sax Halls, Plug Bridged & 10 sax
Cement to Base of Cellar; 2 sax Cement
in Rat Hole. Job completed @ 9:30 P.M.

RECEIVED
STATE CORPORATION COMMISSION
JUN 2 1971
CONSERVATION DIVISION
Wichita, Kansas

6-2-71

(If additional description is necessary, use BACK of this sheet)

Name of Plugging Contractor HOWCO
Address Box 339, Hays, Kansas

STATE OF KANSAS, COUNTY OF SEDGWICK, ss.

Clarence Michael of Sage Drilling Co. (employee of owner) or (owner or operator) of the above described well, being first duly sworn on oath, says: That I have knowledge of the facts, statements, and matters herein contained and the log of the above described well as filed and that the same are true and correct. So help me God.

(Signature) Clarence Michael
500 Bitting Bldg., Wichita, Kansas (Address)

Subscribed and sworn to before me this 1st day of June, 1971

Louise K. Whitted
Notary Public.

My commission expires November 26, 1974.

